

Perry
 15 2007
 10/8/79

MISSISSIPPI
 BOARD OF WATER COMMISSIONERS
 416 North State Street
 Jackson, Mississippi 39201

WATER WELL DRILLERS LOG

Oct 8 1979 E.P. Clark Water Wells Perry
 date well completed firm name county well located

LANDOWNER: George
 Milton, Jr.
 Rt. 2, New Augusta, Mo.
 (mailing address)

description of formations encountered	from	to
Sand	0	29
Sand and Peas	29	97
Clay	97	98

WELL LOCATION:
 sec 27 T 3 N R 11 W
 1 1/2 miles South of Mahan
 (distance) (direction) (nearest town)

WELL PURPOSE: Home
 (home, irrigation, municipal, industrial)

- WELL COMPLETION DATA:
- (1) diameter (inches) 2
 - (2) total depth (feet) 97
 - (3) static water level (feet) 60 below top of ground.
 - (4) casing Galv. St. 92' (material) (depth)
 2" (size) if telescope see back.
 - (5) screen 5' 92' (length) (depth to top)
 1/4" Stainless Steel (size) (material) (006)
 - (6) pump 1 1 1/2 (HP) (yield gpm)
 220V 10 (type power)
 - (7) electric log no (yes or no)
 (organization running log)
 - (8) how well bottom plugged BWW

DEPT. OF NATURAL RESOURCES
 BUREAU OF LAND & WATER RESOURCES


OCT 25 1979

RECEIVED

DRILLERS REMARKS:

If well telescopes please sketch and show depths.

GROUND LEVEL

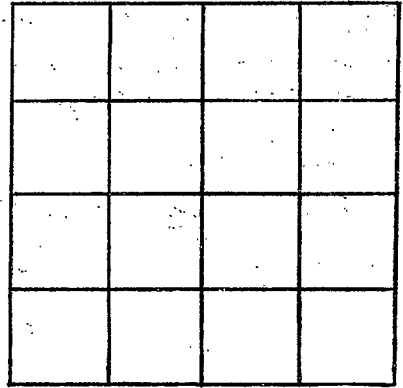

SECTION _____

Please indicate well location X.

ADDITIONAL INFORMATION

If more than one screen, show locations of each on sketch.