

MISSISSIPPI DEPARTMENT OF NATURAL RESOURCES

Bureau of Land and Water Resources

Southport Mall

P.O. Box 10631

Jackson, Mississippi 39209

WATER WELL DRILLERS LOG

PERRY
G 2008
12-23-80

Dec 23 1980 Cochran Brothers Drilling Perry
 date well completed firm name county well located

LANDOWNER:	description of formations encountered	from	to
<u>Willard Ward</u>			
<u>Rt. 12 (Hattiesburg)</u> (mailing address)	<u>TOP SOIL</u>	<u>0</u>	<u>6</u>
	<u>RED CLAY</u>	<u>7</u>	<u>8</u>
	<u>RED SAND & GRAVEL</u>	<u>9</u>	<u>21</u>
	<u>SAND & GRAVEL</u>	<u>21</u>	<u>52</u>

WELL LOCATION:
 sec. 4 T. 3 (N) R. 11 E
5 miles S of Indian Springs
 (distance) (direction) (nearest town)

WELL PURPOSE: home
 (home, irrigation, municipal, industrial)

- WELL COMPLETION DATA:
- (1) diameter (inches) 4"
 - (2) total depth (feet) 52'
 - (3) static water level (feet) 19' below above top of ground.
 - (4) casing PVC 42'
 (material) (depth)
 - if telescope see back.
 (size)
 - (5) screen 10' 42'
 (length) (depth to top)
4" PVC
 (size) (material)
 - (6) pump owner —
 (HP) (yield gpm)
—
 (type power)
 - (7) electric log —
 (yes or no)
—
 (organization running log)
 - (8) how well bottom plugged VALVE

DRILLERS REMARKS: —


DEPT. OF NATURAL RESOURCES
 BUREAU OF LAND & WATER RESOURCES

JAN 8 1981

RECEIVED

If well telescopes please sketch and show depths.

GROUND LEVEL

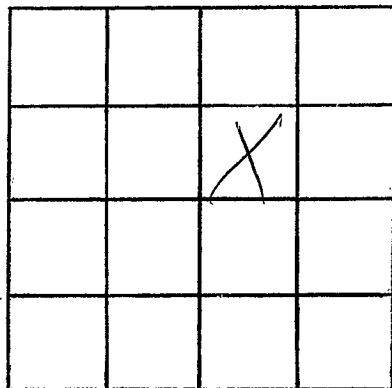

SECTION 4

Please indicate well location X.

ADDITIONAL INFORMATION

If more than one screen,
show locations of each on sketch.