

MISSISSIPPI DEPARTMENT OF NATURAL RESOURCES

Bureau of Land and Water Resources

Southport Mall

P.O. Box 10631

Jackson, Mississippi 39209

WATER WELL DRILLERS LOG

PERRY
 6 2007
 12-22-80
 Dec. 22 1980
 date well completed

80 Cochean Brothers Drilling
 firm name

PERRY
 county well located

LANDOWNER: <u>Gerald Ward</u>	description of formations encountered		from	to
<u>406 Monica Road</u>	<u>Top Soil</u>		<u>0</u>	<u>2</u>
<u>Wattensburg, Miss</u> (mailing address)	<u>Red clay</u>		<u>2</u>	<u>8</u>
	<u>Red Sand</u>		<u>8</u>	<u>19</u>
	<u>sand</u>		<u>19</u>	<u>48</u>
	<u>sand + Corals</u>		<u>48</u>	<u>60</u>
WELL LOCATION:				
sec. <u>4</u> T. <u>3</u> N. R. <u>11</u> E				
<u>5</u> miles <u>S</u> of <u>Indian Lake</u>				
(distance) (direction) (nearest town)				
WELL PURPOSE: <u>home</u>				
(home, irrigation, municipal, industrial)				
WELL COMPLETION DATA:				
(1) diameter (inches) <u>4"</u>				
(2) total depth (feet) <u>60</u>				
(3) static water level (feet) <u>21</u> <u>below</u> top of ground.				
(4) casing <u>PVC</u> <u>50'</u> (material) (depth)				
<u> </u> if telescope see back. (size)				
(5) screen <u>10'</u> <u>50'</u> (length) (depth to top)				
<u>4"</u> <u>PVC</u> (size) (material)				
(6) pump <u>OWNER</u> (HP) (yield gpm)				
<u> </u> (type power)				
(7) electric log <u> </u> (yes or no)				
<u> </u> (organization running log)				
(8) how well bottom plugged <u>value</u>				

DEPT. OF NATURAL RESOURCES
 BUREAU OF LAND & WATER RESOURCES


JAN 8 1981

RECEIVED

DRILLERS REMARKS:

If well telescopes please sketch and show depths.

GROUND LEVEL

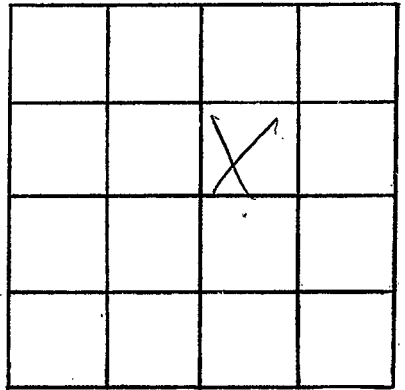

SECTION 4

Please indicate well location X.

ADDITIONAL INFORMATION

If more than one screen,
show locations of each on sketch.