

MISSISSIPPI DEPARTMENT OF NATURAL RESOURCES

Bureau of Land and Water Resources

Southport Mall

P.O. Box 10631

Jackson, Mississippi 39209

WATER WELL DRILLERS LOG

Perry  
9 2010  
10-23-81

Oct. 23, 1981 19 Cochran Brothers Drilling Service Perry  
 date well completed firm name county well located

LANDOWNER:  
Church of God  
Rt 2 New Augusta  
 (mailing address)

description of formations encountered	from	to
<u>TOP SOIL</u>	<u>0</u>	<u>1</u>
<u>Red clay</u>	<u>1</u>	<u>4</u>
<u>White clay</u>	<u>4</u>	<u>7</u>
<u>Sand</u>	<u>7</u>	<u>32</u>

WELL LOCATION:  
 sec 21 T 3 N R 11 E  
 S W  
1/2 miles W of Mahmed  
 (distance) (direction) (nearest town)

WELL PURPOSE:  
 (home, irrigation, municipal, industrial)

WELL COMPLETION DATA:

(1) diameter (inches) 2"

(2) total depth (feet) 32'

(3) static water level (feet) 18' below above top of ground.

(4) casing PVC, 27'  
 (material) (depth)  
5' If telescope see back.  
 (size)

(5) screen 5', 27'  
 (length) (depth to top)  
2", PVC  
 (size) (material)

(6) pump 1/2, 7  
 (HP) (yield gpm)  
elec  
 (type power)

(7) electric log no  
 (yes or no)

(organization running log)

(8) how well bottom plugged VALVE


DRILLERS REMARKS:

DEPT. OF NATURAL RESOURCES  
 BUREAU OF LAND & WATER RESOURCES

DEC - 3 1981  
 RECEIVED

If well telescopes please sketch and show depths.

GROUND LEVEL

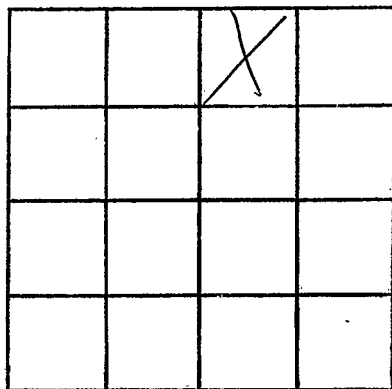

SECTION 2

Please indicate well location X.

ADDITIONAL INFORMATION

If more than one screen, show locations of each on sketch.