

MISSISSIPPI DEPARTMENT OF NATURAL RESOURCES

Bureau of Land and Water Resources

Southport Mall

P.O. Box 10631

Jackson, Mississippi 39209

WATER WELL DRILLERS LOG


Perry  
G 2011  
4-25-81

APRIL 25 1981  
date well completed

Coshean Brothers Drilling Service  
firm name

PERRY  
county well located


LANDOWNER:	description of formations encountered	from	to
David Shows			
Pt. 3 Hattiesburg (mailing address)	Brown clay	1	5
WELL LOCATION:	Gray clay	5	9
sec 22 T 30 S R 11 E	fine sand	9	18
1/2 miles N of MARRISTOWN	sand + GRAVEL	18	45
(distance) (direction) (nearest town)			
WELL PURPOSE: Home			
(home, irrigation, municipal, industrial)			
WELL COMPLETION DATA:			
(1) diameter (inches) 2"			
(2) total depth (feet) 451			
(3) static water level (feet) 13 below top of ground.			
(4) casing PVC, 40' (material), (depth)			
(size) If telescope see back.			
(5) screen 5' 40' (length), (depth to top)			
2" PVC (size), (material)			
(6) pump 1 (HP), 10 (yield gpm)			
Elect. (type power)			
(7) electric log no (yes or no)			
(organization running log)			
(8) how well bottom plugged value			

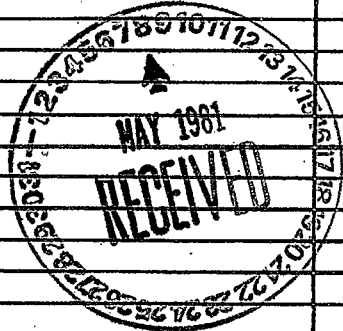

DRILLERS REMARKS:

If well telescopes please sketch and show depths.

GROUND LEVEL

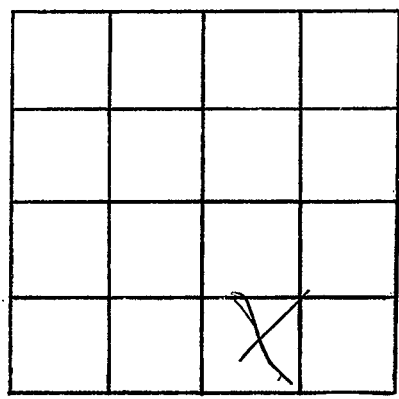

SECTION 22

Please indicate well location X.

ADDITIONAL INFORMATION

If more than one screen, show locations of each on sketch.