

MISSISSIPPI DEPARTMENT OF NATURAL RESOURCES
Bureau of Land and Water Resources
 Southport Mall
 P.O. Box 10631
 Jackson, Mississippi 39209
WATER WELL DRILLERS LOG

50 SW will be G in Forrest Co. 9/12/81

Perry
G 2012
10-1-81

Oct 1 1981 Cochran Brothers Drilling Perry
 date well completed firm name county well located

LANDOWNER:
Shelby Ray Irby
RT 10 Hattiesburg
 (mailing address)

description of formations encountered	from	to
	<u>Top Soil</u>	<u>0</u>
<u>sand</u>	<u>2</u>	<u>8</u>
<u>white clay</u>	<u>8</u>	<u>14</u>
<u>sand</u>	<u>14</u>	<u>50</u>

WELL LOCATION:
 sec. 4 T. 3 N. R. 11 E.
7 miles S.W. of Indian Springs
 (distance) (direction) (nearest town)

WELL PURPOSE: home
 (home, irrigation, municipal, industrial)

- WELL COMPLETION DATA:**
- diameter (inches) 2"
 - total depth (feet) 50'
 - static water level (feet) 12 below above top of ground.
 - casing PVC, 45'
 (material) (depth)
 (size) if telescope see back.
 - screen 5', 45'
 (length) (depth to top)
2", PVC
 (size) (material)
 - pump 1 7
 (HP) (yield gpm)
Elec
 (type power)
 - electric log no
 (yes or no)
 (organization running log)
 - how well bottom plugged value

DRILLERS REMARKS:


DEPT. OF NATURAL RESOURCES
 BUREAU OF LAND & WATER RESOURCES

DEC - 3 1981

RECEIVED

If well telescopes please sketch and show depths.

GROUND LEVEL

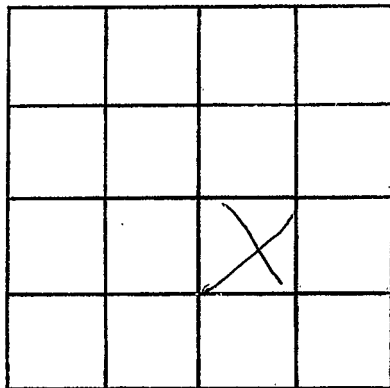

SECTION 4

Please indicate well location X.

ADDITIONAL INFORMATION

If more than one screen,
show locations of each on sketch.