

**MISSISSIPPI DEPARTMENT OF NATURAL RESOURCES**  
**Bureau of Land and Water Resources**  
 Southport Mall  
 P.O. Box 10631  
 Jackson, Mississippi 39209  
**WATER WELL DRILLERS LOG**

*Perry*  
G 203

Jan. 25, 1982 Cochran Brothers Drilling Service PERRY  
 date well completed firm name county well located

**LANDOWNER:**  
CARRIE TRAVIS  
Rt 3 New Augusta  
 (mailing address)

description of formations encountered	from	to
TOP Soil	0	1
Red Clay	1	5
Red Sand	5	12
Sand & Gravel	12	45

**WELL LOCATION:**  
 sec. 7 T. 3 N. R. 11 E.  
S W  
1 miles E of Sheepb  
 (distance) (direction) (nearest town)

**WELL PURPOSE:**  
 (home, irrigation, municipal, industrial)

- WELL COMPLETION DATA:**
- (1) diameter (inches) 2"
  - (2) total depth (feet) 45'
  - (3) static water level (feet) 15 <sup>below</sup> <sub>above</sub> top of ground.
  - (4) casing PVC, 40'  
 (material) (depth)
  - if telescope see back.  
 (size)
  - (5) screen 5', 40'  
 (length) (depth to top)
  - 2", PVC  
 (size) (material)
  - (6) pump 1 8  
 (HP) (yield gpm)
  - Elec  
 (type power)
  - (7) electric log NO  
 (yes or no)
  - (organization running log)
  - (8) how well bottom plugged LR/LP

**DRILLERS REMARKS:**


DEPT. OF NATURAL RESOURCES  
 BUREAU OF LAND & WATER RESOURCES

FEB 23 1982

**RECEIVED**

If well telescopes please sketch and show depths.

GROUND LEVEL

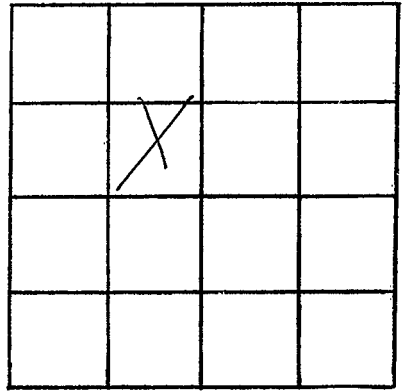

SECTION 7

Please indicate well location X.

ADDITIONAL INFORMATION

If more than one screen, show locations of each on sketch.