

Perry
G 2014

MISSISSIPPI
 BOARD OF WATER COMMISSIONERS
 416 North State Street
 Jackson, Mississippi 39201

WATER WELL DRILLERS LOG

Jan 21 1982 C.P. Clark W Wells Perry
 (date well completed) (firm name) (county well located)

LANDOWNER: Bonnie Edwards

description of formations encountered

from to

<u>surf soil</u>	<u>0</u>	<u>2</u>
<u>Red clay</u>	<u>2</u>	<u>5</u>
<u>gravel</u>	<u>5</u>	<u>18</u>
<u>gray/green clay</u>	<u>18</u>	<u>196</u>
<u>reddish clay</u>	<u>196</u>	<u>206</u>
<u>sand</u>	<u>206</u>	<u>231</u>
<u>sand w/ clay breaks</u>	<u>231</u>	<u>235</u>

Nattiesburg, Miss.
 (mailing address)

WELL LOCATION:

sec. 13 T. 3 N R. 11 W
1 miles N of New Augusta
 (distance) (direction) (nearest town)

WELL PURPOSE: home
 (home, irrigation, municipal, industrial)

WELL COMPLETION DATA:

- (1) diameter (inches) 4
- (2) total depth (feet) 232
- (3) static water level (feet) 30 below above top of ground.
- (4) casing Galv. 222'
 (material) (depth)
 (size) If telescope see back.
- (5) screen 10' 222
 (length) (depth to top)
4" Stainless Steel
 (size) (material)
- (6) pump 3 45 @ OPSI
 (HP) (yield gpm)
230V 3φ
 (type power)
- (7) electric log no
 (yes or no)
no
 (organization running log)
- (8) how well bottom plugged BWV

DRILLERS REMARKS:


DEPT. OF NATURAL RESOURCES
 BUREAU OF LAND & WATER RESOURCES

FEB - 8 1982

RECEIVED

If well telescopes please sketch and show depths.

GROUND LEVEL

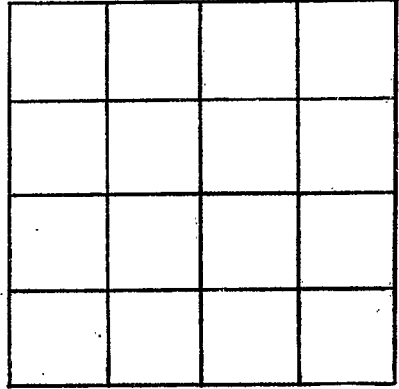

SECTION _____

Please indicate well location 'X'.

ADDITIONAL INFORMATION

If more than one screen, show locations of each on sketch.

82 FEB 2 10 48

RECEIVED