

**MISSISSIPPI DEPARTMENT OF NATURAL RESOURCES**  
**Bureau of Land and Water Resources**  
 Southport Mall  
 P.O. Box 10631  
 Jackson, Mississippi 39209  
**WATER WELL DRILLERS LOG**

*Perry*  
**G 2018**

July 14 - 1982 Cochran Bros. Drilling Service PERRY  
 date well completed firm name county well located

LANDOWNER:	description of formations encountered	from	to
<u>Alan Maxwell</u>			
<u>Rt. 1 New Augusta</u> (mailing address) <u>D</u>	<u>Red clay</u>	<u>2</u>	<u>8</u>
	<u>sand + gravel</u>	<u>8</u>	<u>60</u>
<b>WELL LOCATION:</b>			
sec. <u>8</u> T. <u>3</u> N. R. <u>11</u> E. <small>S W</small>			
<u>7</u> miles <u>SW</u> of <u>Indian Springs</u> <small>(distance) (direction) (nearest town)</small>			
<b>WELL PURPOSE:</b> <u>None</u> <small>(home) irrigation, municipal, industrial</small>			
<b>WELL COMPLETION DATA:</b>			
(1) diameter (inches) <u>4"</u>			
(2) total depth (feet) <u>60'</u>			
(3) static water level (feet) <u>20</u> <small>below</small> above top of ground.			
(4) casing <u>PVC</u> <u>50'</u> <small>(material) (depth)</small>			
<u>—</u> if telescope see back. <small>(size)</small>			
(5) screen <u>10' 50'</u> <small>(length) (depth to top)</small>			
<u>4"</u> <u>PVC</u> <small>(size) (material)</small>			
(6) pump <u>—</u> <u>—</u> <small>(HP) (yield gpm)</small>			
<u>—</u> <small>(type power)</small>			
(7) electric log <u>—</u> <small>(yes or no)</small>			
<u>—</u> <small>(organization running log)</small>			
(8) how well bottom plugged <u>value</u>			

DEPT. OF NATURAL RESOURCES  
 BUREAU OF LAND & WATER RESOURCES


OCT - 4 1982

**RECEIVED**

DRILLERS REMARKS: —

If well telescopes please sketch and show depths.

GROUND LEVEL

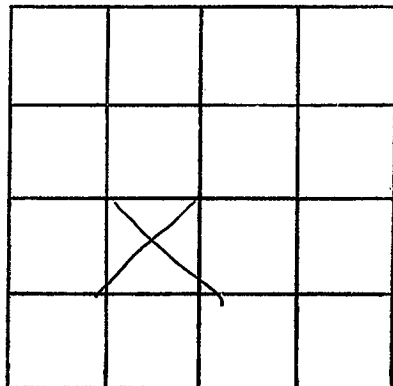

SECTION 8

Please indicate well location X.

ADDITIONAL INFORMATION

If more than one screen,  
show locations of each on sketch.