

MISSISSIPPI DEPARTMENT OF NATURAL RESOURCES

Bureau of Land and Water Resources

Southport Mall

P.O. Box 10631

Jackson, Mississippi 39209

WATER WELL DRILLERS LOG

<i>Perry</i>
<i>G</i>
<i>2021</i>

March 12 83 Cochran Water Well Perry  
 date well completed firm name county well located

LANDOWNER:	description of formations encountered	from	to
<u>Jerry Crawford</u>	<u>TOP soil</u>	<u>0</u>	<u>2</u>
<u>Rt 12 Natchiesburg</u> (mailing address)	<u>Red clay</u>	<u>2</u>	<u>6</u>
<b>WELL LOCATION:</b>	<u>Red sand</u>	<u>6</u>	<u>12</u>
sec. <u>4</u> T. <u>3</u> N. R. <u>11</u> E. <u>(W)</u>	<u>gray clay</u>	<u>12</u>	<u>23</u>
<u>4</u> miles <u>S</u> of <u>Indian Spring</u> (distance) (direction) (nearest town)	<u>sand &amp; gravel</u>	<u>23</u>	<u>28</u>
<b>WELL PURPOSE:</b> (home, irrigation, municipal, industrial)			
<b>WELL COMPLETION DATA:</b>			
(1) diameter (inches) <u>2 1/2</u>			
(2) total depth (feet) <u>78'</u>			
(3) static water level (feet) <u>18</u> below above top of ground.			
(4) casing <u>PVC</u> <u>73'</u> (material) (depth)			
(size) if telescope see back.			
(5) screen <u>51</u> <u>73'</u> (length) (depth to top)			
<u>2 1/2</u> <u>PVC</u> (size) (material)			
(6) pump <u>1</u> <u>6</u> (HP) (yield gpm)			
<u>Else</u> (type power)			
(7) electric log <u>no</u> (yes or no)			
(organization running log)			
(8) how well bottom plugged <u>valve</u>			

DEPT. OF NATURAL RESOURCES  
BUREAU OF LAND & WATER RESOURCES


APR 27 1983

RECEIVED

DRILLERS REMARKS:

If well telescopes please sketch and show depths.

GROUND LEVEL

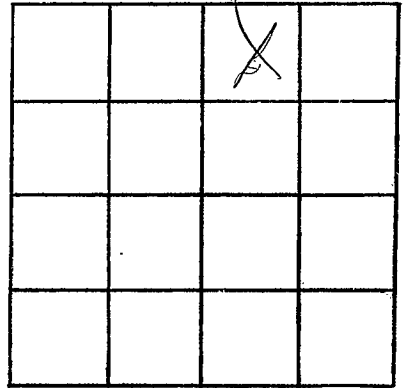

SECTION 4

Please indicate well location X.

ADDITIONAL INFORMATION

A series of horizontal lines for writing additional information.

If more than one screen, show locations of each on sketch.