

MISSISSIPPI DEPARTMENT OF NATURAL RESOURCES
Bureau of Land and Water Resources
 Southport Mall
 P.O. Box 10631
 Jackson, Mississippi 39209
WATER WELL DRILLERS LOG

Perry
6
2022

April 25 1983 77 Cochran Waterwell Service Perry
 date well completed firm name county well located

| LANDOWNER: | description of formations encountered | from | to |
|--|---------------------------------------|-----------|-----------|
| <u>Joe Dennis</u> | | | |
| <u>Rt 12 Hattiesburg</u> (mailing address) | <u>Red clay</u> | <u>2</u> | <u>6</u> |
| WELL LOCATION: | <u>DRAY CLAY</u> | <u>6</u> | <u>18</u> |
| sec. <u>10</u> T. <u>3</u> N. R. <u>11</u> E. | <u>Sand & Gravel</u> | <u>18</u> | <u>78</u> |
| <u>5</u> miles <u>S</u> of <u>Indian Springs</u> | | | |
| (distance) (direction) (nearest town) | | | |
| WELL PURPOSE: (home irrigation, municipal, industrial) | | | |
| WELL COMPLETION DATA: | | | |
| (1) diameter (inches) <u>2"</u> | | | |
| (2) total depth (feet) <u>78'</u> | | | |
| (3) static water level (feet) <u>28'</u> <u>below</u> top of ground. | | | |
| (4) casing <u>PVC</u> , <u>73'</u> (material) (depth) | | | |
| (size) if telescope see back. | | | |
| (5) screen <u>5'</u> , <u>73'</u> (length) (depth to top) | | | |
| <u>2"</u> , <u>PVC</u> (size) (material) | | | |
| (6) pump <u>1</u> , <u>8</u> (HP) (yield gpm) | | | |
| <u>4000</u> (type power) | | | |
| (7) electric log <u>no</u> (yes or no) | | | |
| (organization running log) | | | |
| (8) how well bottom plugged <u>valve</u> | | | |
| DRILLERS REMARKS: | | | |


DEPT. OF NATURAL RESOURCES
 BUREAU OF LAND & WATER RESOURCES

AUG 17 1983

RECEIVED

If well telescopes please sketch and show depths.

GROUND LEVEL

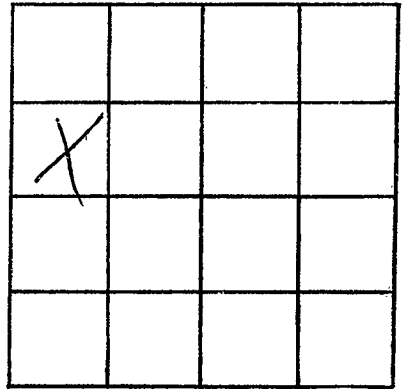

SECTION

05

Please indicate well location X.

ADDITIONAL INFORMATION

If more than one screen, show locations of each on sketch.