

**MISSISSIPPI DEPARTMENT OF NATURAL RESOURCES**  
**Bureau of Land and Water Resources**  
 Southport Mall  
 P.O. Box 10631  
 Jackson, Mississippi 39209  
**WATER WELL DRILLERS LOG**

Perry  
G 2024

November 21-85 date well completed    Cochran Water Well Serv firm name    Perry county well located

**LANDOWNER:**  
Claude Jackson  
Rd. 1 New Augusta  
 (mailing address)

description of formations encountered	from	to
TOP SOIL	0	1
red sandy clay	1	4
sand & gravel	4	38

**WELL LOCATION:**  
 sec. 2 T. 3 (N) R. 11 (E)  
5 miles N of New Augusta  
 (distance) (direction) (nearest town)

**WELL PURPOSE:**  
 (home) Irrigation, municipal, industrial

- WELL COMPLETION DATA:**
- (1) diameter (inches) 2"
  - (2) total depth (feet) 38'
  - (3) static water level (feet) 6  below top of ground.  above
  - (4) casing PVC, 33'  
 (material) (depth)  
 (size) If telescope see back.
  - (5) screen 5', 33'  
 (length) (depth to top)  
2", PVC  
 (size) (material)
  - (6) pump \_\_\_\_\_ (HP) \_\_\_\_\_ (yield gpm)  
 (type power)
  - (7) electric log \_\_\_\_\_ (yes or no)  
 (organization running log)
  - (8) how well bottom plugged water


**RECEIVED**  
 DEC 3 - 1985

Mississippi Department of Natural Resources  
 Bureau of Land and Water Resources

**DRILLERS REMARKS:**

If well telescopes please sketch and show depths.

GROUND LEVEL

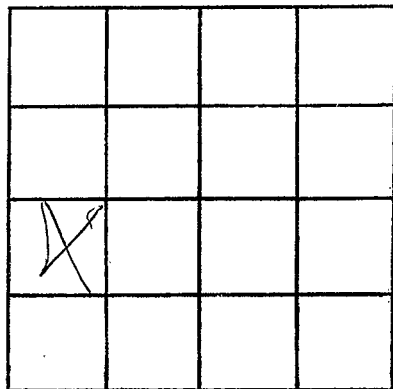

SECTION 2

Please indicate well location X.

ADDITIONAL INFORMATION

If more than one screen,  
show locations of each on sketch.