

MISSISSIPPI DEPARTMENT OF NATURAL RESOURCES

Bureau of Land and Water Resources

Southport Mall

P.O. Box 10631

Jackson, Mississippi 39209

WATER WELL DRILLERS LOG

Perry  
G 2025

July 25, 1986 date well completed  
Cochran Water Works firm name  
Perry county well located

LANDOWNER:	description of formations encountered	from	to
Rickie Collins	TOP Soil	0	2
Rt 1 New Augusta (mailing address)	red clay	2	5
WELL LOCATION:	Gray clay	5	11
sec. 4 T 30 N S R 11 E W	sand	11	65
7 miles NW of Perry (distance) (direction) (nearest town)			
WELL PURPOSE: (home, irrigation, municipal, industrial)			
WELL COMPLETION DATA:			
(1) diameter (inches) 2"			
(2) total depth (feet) 65'			
(3) static water level (feet) 21' below top of ground.			
(4) casing PVC 60' (material), (depth)			
2" (size) if telescope see back.			
(5) screen 51' 60' (length), (depth to top)			
2" (size), PVC (material)			
(6) pump + (HP), (yield gpm)			
(type power)			
(7) electric log (yes or no)			
(organization running log)			
(8) how well bottom plugged Vahl			

RECEIVED


NOV 14 1986

Department of Natural Resources  
Bureau of Land & Water Resources

DRILLERS REMARKS:

If well telescopes please sketch and show depths.

GROUND LEVEL

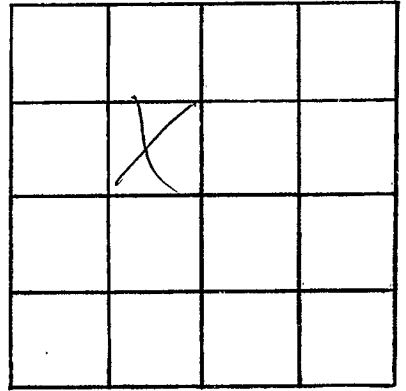

SECTION 4

Please indicate well location X.

ADDITIONAL INFORMATION

If more than one screen,  
show locations of each on sketch.