

Perry
G 2006

MISSISSIPPI DEPARTMENT OF NATURAL RESOURCES
Bureau of Land and Water Resources
Southport Mall
P.O. Box 10631
Jackson, Mississippi 39209
WATER WELL DRILLERS LOG

2-1-86 19 Tom Griffith Well Service Perry
date well completed firm name county well located

LANDOWNER: <u>Roosevelt Mason</u>	description of formations encountered		from	to
(mailing address)	CLAY		0	10
	P-Gravel		10	27
WELL LOCATION: sec. <u>11</u> T. <u>3</u> S. R. <u>11</u> E. <u>5</u> miles <u>North</u> of <u>New Aquas</u> (distance) (direction) (nearest town)	CLAY		27	110
	SAND		110	115
	CLAY		115	243
	SAND		243	260
WELL PURPOSE: <u>None</u> (home, irrigation, municipal, industrial)				
WELL COMPLETION DATA:				
(1) diameter (inches) <u>4"</u>				
(2) total depth (feet) <u>260'</u>				
(3) static water level (feet) <u>40'</u> below above top of ground.				
(4) casing <u>PVC</u> , <u>240'</u> (material) (depth) <u>4"</u> if telescope see back. (size)				
(5) screen <u>20'</u> , <u>240'</u> (length) (depth to top) <u>4"</u> , <u>PVC #.010</u> (size) (material)				
(6) pump <u>3/4</u> , <u>20'</u> (HP) (yield gpm) <u>220V</u> (type power)				
(7) electric log <u>No</u> (yes or no) <u>NA</u> (organization running log)				
(8) how well bottom plugged <u>BWV</u>				
DRILLERS REMARKS: <u>Fine Sand / Weak Strata / Well finally failed due to production of fine sand</u>				

RECEIVED


NOV 7 1986

Department of Natural Resources
Bureau of Land & Water Resources

Possibly due to parted Csg, There was no other indication of a parted casing but yet it may have been

If well telescopes please sketch and show depths.

GROUND LEVEL

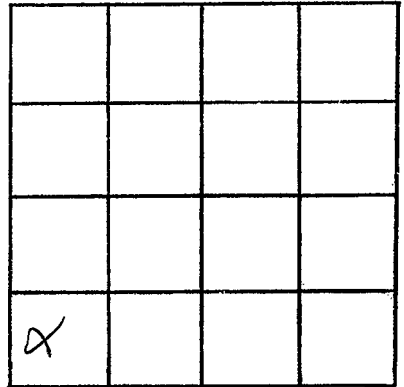

SECTION _____

Please indicate well location X.

ADDITIONAL INFORMATION

If more than one screen,
show locations of each on sketch.