

# MISSISSIPPI DEPARTMENT OF NATURAL RESOURCES

Bureau of Land and Water Resources

P.O. Box 10631

Jackson, Mississippi 39209

## WATER WELL DRILLERS LOG

COUNTY WELL LOCATED <i>Perry</i>
WELL NUMBER (CODED) <i>G2028</i>
DATE WELL COMPLETED <i>Dec 5 - 1987</i>

PERMIT NUMBER
NAME OF DRILLING FIRM <i>Cochran Water Well Services</i>

NAME & MAILING ADDRESS OF LANDOWNER <i>Troy Mc Gee</i> <i>Rd 2 Pecton</i>			
WELL LOCATION:	SEC <i>22</i>	TOWNSHIP <i>3</i>	RANGE <i>11</i>
DISTANCE <i>7</i> Miles	DIRECTION <i>NW</i>	NEAREST TOWN <i>Rowlett</i>	
OTHER LANDMARK			
WELL PURPOSE: Home Irrigation, Municipal, Industrial, Fish Pond, etc.			

PUMP DATA		
PUMP TYPE (Circle One): Submersible, Turbine, <u>Jet</u> , Flowing Well, Other (Describe) _____		
POWER TYPE (Circle One): <u>Electric</u> , Tractor, Diesel, Gasoline, Butane, Other (Describe) _____		
Pump Capacity (GPM) <i>8</i>	No. of Stages <i>2</i>	Setting Depth <i>20</i> FT.
PUMP TEST		
Well yielded _____ GPM with a drawdown of _____ ft. after _____ hours of pumping		

WELL DATA		
Well Depth <i>25'</i>	Casing Diameter (In.) <i>2</i>	Casing Length (FL) <i>20'</i>
Type of Casing <i>PIC</i>	Hole Depth <i>25'</i>	Depth to Static Water Level <i>8'</i>
TYPE OF COMPLETION: (Circle One or More): <u>Natural Development</u> , Gravel Packed, Underreamed, Telescoped, Open Hole, Other (Describe) _____		
Top of Lap Pipe or Reduction in Casing  FEET IF TELESCOPED OR MORE THAN ONE SCREEN: USE BACK PAGE		

LOG DATA	
TYPE OF LOG RUN (Circle One): No <u>Log Run</u> , Electric, Gamma Ray, Density, Sonic, Neutron, Other (Describe) _____	
Name of Organization Running Log	

SCREEN DATA		
Diameter - Inches <i>2</i>	Length - Feet <i>5</i>	Slot Size - Inches <i>10</i>
Screen Type <i>PIC</i>		Depth to Bottom - Feet <i>25</i>


GEOLOGIC DATA (Office Use Only)			
Surface Elev.	Geologic Unit	Unit Thickness	Depth to Top
Subs. SWL	Date	Analysis	Aquifer Test

Driller's Remarks
-------------------

DESCRIPTION OF FORMATIONS ENCOUNTERED	FROM	TO	FORMATIONS (Continued)	FROM	TO
<i>Top soil</i>	<i>0</i>	<i>1</i>			
<i>gray clay</i>	<i>1</i>	<i>8</i>			
<i>sand</i>	<i>8</i>	<i>25</i>			
Department of Natural Resources Bureau of Land & Water Resources					
IF MORE SPACE IS NEEDED, USE BACK					

If well telescopes please sketch and show depths.

GROUND LEVEL

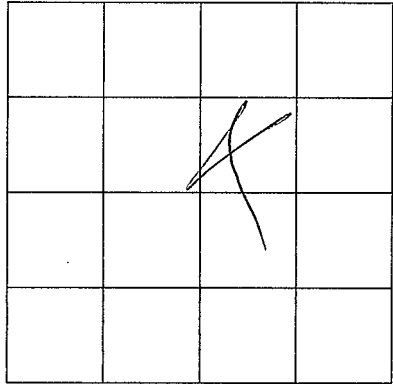

SECTION *22*

Please indicate well location X.

ADDITIONAL INFORMATION

If more than one screen,  
show location of each on sketch.