

MISSISSIPPI DEPARTMENT OF NATURAL RESOURCES

Bureau of Land and Water Resources

P.O. Box 10631
Jackson, Mississippi 39209
WATER WELL DRILLERS LOG

COUNTY WELL LOCATED <i>Perry</i>	
WELL NUMBER <i>G 2027</i>	CODED
DATE WELL COMPLETED <i>10-10-87</i>	

PERMIT NUMBER
NAME OF DRILLING FIRM <i>Copman Water Well Sewer</i>

NAME & MAILING ADDRESS OF LANDOWNER
Rt 1 new Augusta
Alvin Fay Barrett

WELL LOCATION: SEC *2* TOWNSHIP *3^N S* RANGE *11^E W*

DISTANCE *6* Miles *N* of *New Augusta*

OTHER LANDMARK

WELL PURPOSE: *H* Home Irrigation, Municipal, Industrial, Fish Pond, etc.

PUMP DATA

PUMP TYPE (Circle One):
Submersible, Turbine, *Jet* (circled), Flowing Well, Other (Describe)

POWER-TYRE (Circle One):
Electric (circled), Tractor, Diesel, Gasoline, Butane, Other (Describe)

Pump Capacity (GPM) <i>8</i>	No. of Stages <i>2</i>	Setting Depth <i>30</i> FT.
---------------------------------	---------------------------	--------------------------------

PUMP TEST

Well yielded _____ GPM with a drawdown of _____ ft. after _____ hours of pumping

WELL DATA

Well Depth <i>55'</i>	Casing Diameter (In.) <i>2"</i>	Casing Length (Ft.) <i>50'</i>
Type of Casing <i>PVC</i>	Hole Depth <i>55'</i>	Depth to Static Water Level <i>13'</i>

TYPE OF COMPLETION: (Circle One or More):
~~Gravel Packed~~, Underreamed, Telescoped, *Natural Development* (circled), Open Hole, Other

Top of Lap Pipe or Reduction in Casing
FEET. IF TELESKOPED OR MORE THAN ONE SCREEN: USE BACK PAGE

LOG DATA

TYPE OF LOG RUN (Circle One): *No Log Run* (circled), Electric, Gamma Ray, Density, Sonic, Neutron, Other (Describe)

Name of Organization Running Log

SCREEN DATA

Diameter - Inches <i>2"</i>	Length - Feet <i>5'</i>	Slot Size - Inches <i>10</i>
Screen Type <i>PVC</i>	Depth to Bottom - Feet <i>55</i>	

GEOLOGIC DATA (Office Use Only)

Surface Elev.	Geologic Unit	Unit Thickness	Depth to Top
Subs. SWL	Date	Analysis	Aquifer Test

Driller's Remarks


RECEIVED

DESCRIPTION OF FORMATIONS ENCOUNTERED	FROM	TO	FORMATIONS (Continued)	FROM	TO
<i>TOP SOIL</i>	<i>0</i>	<i>2</i>			
<i>broken clay</i>	<i>2</i>	<i>5</i>			
<i>gray clay</i>	<i>5</i>	<i>9</i>			
<i>sand</i>	<i>9</i>	<i>55</i>			

IF MORE SPACE IS NEEDED, USE BACK

If well telescopes please sketch and show depths.

GROUND LEVEL

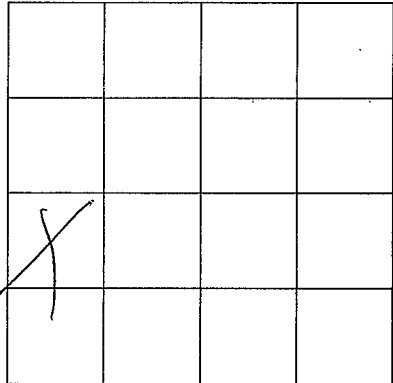

SECTION 2

Please indicate well location X.

ADDITIONAL INFORMATION

If more than one screen,
show location of each on sketch.