

MISSISSIPPI DEPARTMENT OF ENVIRONMENTAL QUALITY
Bureau of Land and Water Resources

P. O. Box 10631
Jackson, MS 39289-0631
WATER WELL DRILLERS LOG

COUNTY WELL LOCATED <i>Perry</i>	
WELL NUMBER <i>2032</i>	CODED
DATE WELL COMPLETED <i>5-25-92</i>	

PERMIT NUMBER <i>0-402</i>
NAME OF DRILLING FIRM <i>Tom Griffith</i>
<i>Water Well Inc.</i>

NAME & MAILING ADDRESS OF LANDOWNER <i>A.L. Williams</i>		
<i>HWY 98W</i>		
<i>New Augusta Miss.</i>		
WELL LOCATION: SEC	TOWNSHIP	RANGE
<i>19</i>	<i>3</i>	<i>11</i>
DISTANCE	DIRECTION	NEAREST TOWN
<i>6</i> Miles	<i>W</i>	<i>new Augusta</i>
OTHER LANDMARK		
WELL PURPOSE: Home, Irrigation, Municipal, Industrial, Fish Pond, etc. <i>Home</i>		

PUMP DATA		
PUMP TYPE (Circle One): Submersible, Turbine, <u>Jet</u> Flowing Well, Other (Describe) _____		
POWER TYPE (Circle One): Electric, Tractor, Diesel, Gasoline, Butane, Other (Describe) _____ H/P _____		
Pump Capacity (GPM)	No. of Stages	Setting Depth
		FT.
PUMP TEST		
Well yielded _____ GPM with a drawdown of _____ ft. after _____ hours of pumping		

WELL DATA		
Well Depth <i>25 FT</i>	Casing Diameter (In.) <i>2 in</i>	Casing Length (Ft.) <i>20</i>
Type of Casing <i>PVC</i>	Hole Depth <i>25 FT</i>	Depth to Static Water Level <i>9</i>
TYPE OF COMPLETION: (Circle One or More): <u>Gravel Packed</u> , Underreamed, Telescoped, <u>Natural Development</u> , Open Hole, Other		
Top of Lap Pipe or Reduction in Casing		
FEET	IF TELESCOPED OR MORE THAN ONE SCREEN: USE BACK PAGE	

LOG DATA	
TYPE OF LOG RUN (Circle One): No Log Run, Electric, Gamma Ray, Density, Sonic, Neutron, Other (Describe) _____	
Name of Organization Running Log	


SCREEN DATA		
Diameter - Inches <i>2 in</i>	Length - Feet <i>5</i>	Slot Size - Inches <i>010</i>
Screen Type <i>PVC 510T</i>	Depth to Bottom - Feet <i>20-25</i>	

GEOLOGIC DATA (Office Use Only)			
Surface Elev.	Geologic Unit	Unit Thickness	Depth to Top
Subs. SWL	Date	Analysis	Aquifer Test
Driller's Remarks <i>Pump supplied BY owner</i>			

DESCRIPTION OF FORMATIONS ENCOUNTERED	FROM	TO	FORMATIONS (Continued)	FROM	TO
<i>Sand</i>	<i>0</i>	<i>6</i>	RECEIVED		
<i>Clay</i>	<i>6</i>	<i>12</i>			
<i>Sand</i>	<i>12</i>	<i>25</i>			
			DEC. 28 1992		
			Dept. of Environmental Quality Bureau of Land & Water Resources		
			IF MORE SPACE IS NEEDED, USE BACK		

If well telescopes please
sketch and show depths.

GROUND LEVEL

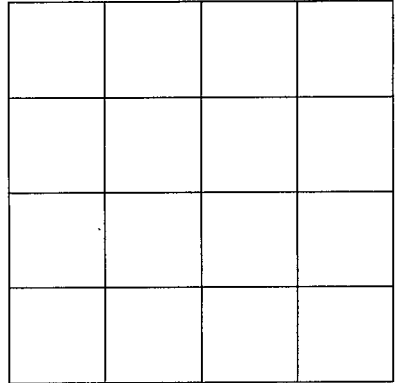

SECTION _____

Please indicate well location X.

ADDITIONAL INFORMATION

If more than one screen,
show location of each on sketch.