

MISSISSIPPI DEPARTMENT OF ENVIRONMENTAL QUALITY
Office of Land and Water Resources

P. O. Box 10631
Jackson, MS 39289-0631
WATER WELL DRILLERS LOG

COUNTY WELL LOCATED <u>Perry</u>	
WELL NUMBER <u>G-2041</u>	CODED
DATE WELL COMPLETED <u>5-10-01</u>	

PERMIT NUMBER
NAME OF DRILLING FIRM <u>Boone's Water Well</u>

NAME & MAILING ADDRESS OF LANDOWNER <u>Anthony Runnels</u>			
<u>254-Old Hwy 24</u>			
<u>New Augusta, MS 39462</u>			
WELL LOCATION: SEC	TOWNSHIP	RANGE	
<u>23</u>	<u>3</u>	<u>11</u>	<u>E</u>
DISTANCE	DIRECTION	NEAREST TOWN	
<u>3</u> Miles	<u>W</u>	of <u>New Augusta</u>	
OTHER LANDMARK			
WELL PURPOSE: <input checked="" type="radio"/> Home Irrigation, Municipal, Industrial, Fish Pond, etc.			

PUMP DATA		
PUMP TYPE (Circle One): Submersible, Turbine, <input checked="" type="radio"/> Jet, Flowing Well, Other (Describe) _____		
POWER TYPE (Circle One): <input checked="" type="radio"/> Electric, Tractor, Diesel, Gasoline, Butane, Other (Describe) _____ H/P <u>1</u>		
Pump Capacity (GPM) <u>5</u>	No. of Stages <u>2</u>	Setting Depth <u> </u> FT.
PUMP TEST		
Well yielded _____ GPM with a drawdown of _____ ft. after _____ hours of pumping		

WELL DATA		
Well Depth <u>20</u>	Casing Diameter (In.) <u>2</u>	Casing Length (Ft.) <u>10</u>
Type of Casing <u>SCH 40</u>	Hole Depth <u>20</u>	Depth to Static Water Level <u>12</u>
TYPE OF COMPLETION: (Circle One or More): <input checked="" type="checkbox"/> Gravel Packed, <input type="checkbox"/> Underreamed, <input type="checkbox"/> Telescoped, <input type="checkbox"/> Natural Development, <input type="checkbox"/> Open Hole, <input type="checkbox"/> Other		
WELL GROUTED TO A DEPTH OF <u>10</u> FEET Type Grout (circle one): <input checked="" type="radio"/> cement, Bentonite, or Mix		

LOG DATA	
TYPE OF LOG RUN (Circle One): No Log Run, Electric, Gamma Ray, Density, Sonic, Neutron, Other (Describe) _____	
Name of Organization Running Log	

SCREEN DATA		
Diameter - Inches <u>2</u>	Length - Feet <u>10</u>	Slot Size - Inches <u>#8</u>
Screen Type <u>SCH 40</u>	Depth to Bottom - Feet	

GEOLOGIC DATA (Office Use Only)			
Surface Elev.	Geologic Unit	Unit Thickness	Depth to Top
Subs. SWL	Date	Analysis	Aquifer Test
Driller's Remarks			
Top of Lap Pipe or Reduction in Casing			
FEET		IF TELESCOPED OR MORE THAN ONE SCREEN: USE BACK PAGE	


DESCRIPTION OF FORMATIONS ENCOUNTERED	FROM	TO
<u>Sand</u>	<u>0</u>	<u>20</u>

FORMATIONS (Continued)	FROM	TO

REC'D AUG 24 2001

If well telescopes please
sketch and show depths.

GROUND LEVEL

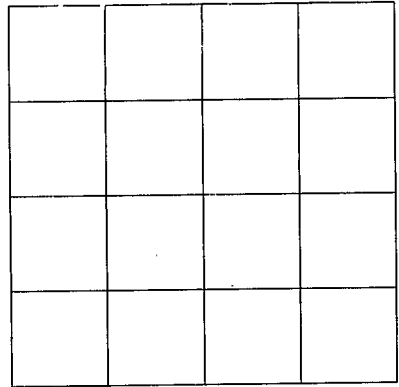

SECTION _____

Please indicate well location X.

ADDITIONAL INFORMATION

If more than one screen,
show location of each on sketch.