

6228

ELOG # 86

MISSISSIPPI
 BOARD OF WATER COMMISSIONERS
 416 North State Street
 Jackson, Mississippi 39201

CODED

WATER WELL DRILLERS LOG

PERRY

H 10

6-13-70 68

June 13 1970
date well completed

68
Dean Driner
firm name

Perry
county well located

LANDOWNER: State Highway Dept.

Rest area - (PROJ.)
LSF-014-3(C)
(mailing address)

description of formations encountered

from to

WELL LOCATION:

sec 27 T³ N 7 R 10 E
2 1/2 miles South of Jackson
(distance) (direction) (nearest town)

Sand	0-12
Clay	12-23
Clay & rock	23-98
Sandy shale	98-108
Clay	108-180
Sand	180-208
Sandy shale	208-508
Sand	508-530
Sandy shale	530-612
Sand	612-624
Sandy shale	624-712
Sand	712-731
Sandy shale	731-750
Sand	750-816

WELL PURPOSE: Rest area
(home, irrigation, municipal, industrial)

WELL COMPLETION DATA:

- (1) diameter (inches) 4"
- (2) total depth (feet) 816
- (3) static water level (feet) 8 below top of ground
- (4) casing, Steel 791, (material) (depth)
- (size) if telescope see back.
- (5) screen 25' 791 (length) (depth to top)
- 4" Standard Steel (size) (material)
- (6) pump 1 3/4 HP (HP) (yield gpm)

Shallow well jet pump (type power)

(7) electric log yes

Miss. S. Survey (organization running log)

(8) how well bottom plugged

DRILLERS REMARKS:


CODED

NOV 30 1970

MISS. DD. OF WATER COMM.

If well telescopes please sketch and show depths.

GROUND LEVEL

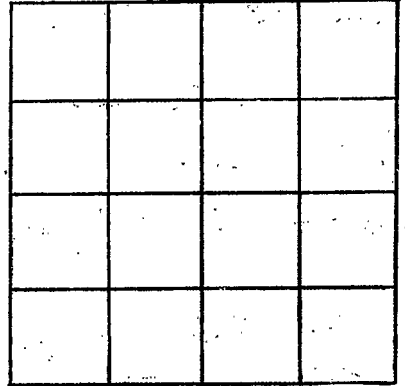

SECTION _____

Please indicate well location X.

ADDITIONAL INFORMATION

If more than one screen,
show locations of each on sketch.