

Perry
H13
6-5-70

MISSISSIPPI
BOARD OF WATER COMMISSIONERS
416 North State Street
Jackson, Mississippi 39201

WATER WELL DRILLERS LOG

CODED

6-5 1970 STR Perry
date well completed firm name county well located

LANDOWNER: Frank & Henry
R.F.D. 1
New Augusta, Miss
(mailing address)

description of formations encountered	from	to
Clay	0	11
Fine Sand	11	18
Clay	18	129
Fine Sand	129	156
Fine Sand	156	169
CWB Sand	169	192

WELL LOCATION:
sec 29 T-3 N R-10 E
1 miles E of New Augusta
(distance) (direction) (nearest town)

WELL PURPOSE: Home
(home, irrigation, municipal, industrial)

- WELL COMPLETION DATA:
- (1) diameter (inches) 2"
 - (2) total depth (feet) 192
 - (3) static water level (feet) 38 below above top of ground.
 - (4) casing Plastic, 182, (material) (depth)
2" (size) if telescope see back.
 - (5) screen 10 ft 182 (length) (depth to top)
2" (size) Plastic (material)
 - (6) pump 1 800 gpm (HP) (yield gpm)
Jest (type power)
 - (7) electric log (yes or no)
(organization running log)
 - (8) how well bottom plugged Valve


CODED

DRILLERS REMARKS:

JUN 29 1970

If well telescopes please sketch and show depths.

GROUND LEVEL

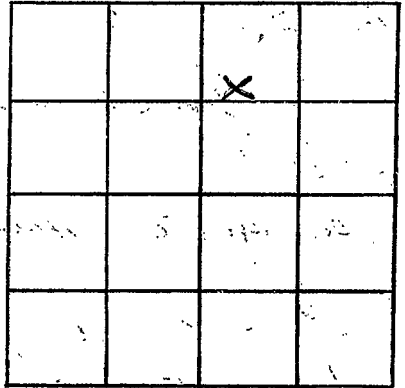

SECTION 29

Please indicate well location X.

ADDITIONAL INFORMATION

If more than one screen, show locations of each on sketch.