

PERRY

H15

11-10-70

MISSISSIPPI
 BOARD OF WATER COMMISSIONERS
 416 North State Street
 Jackson, Mississippi 39201

CODED

WATER WELL DRILLERS LOG

11-10

1970

S+R

Jenny
county well located

LANDOWNER:

State Army Dept.

description of formations encountered

from to

Hartley Dept

Blue Clay

0 21

Jackson, Miss.
(mailing address)

fine sand

21 27

white clay

27 38

red sand

38 46

blue clay

46 181

red sand

181 210

WELL LOCATION:

sec. 22 T 3 N 2 R 10 E
S W
3 miles (distance) direction nearest town

CODED

WELL PURPOSE:

(home, irrigation, municipal, industrial)

WELL COMPLETION DATA:

- (1) diameter (inches) 4 X 2
- (2) total depth (feet) 210
- (3) static water level (feet) 58 below top of ground.
- (4) casing plastic, 200 (material) (depth)
4 X 2 (size) if telescope see back.
- (5) screen 10 (length) 200 (depth to top)
2" d (size) plastic (material)
- (6) pump 1/2 (HP) 18 (yield gpm)
Sub (type power)
- (7) electric log (yes or no)
 (organization running log)
- (8) how well bottom plugged None

Drilled 2
wells here
Bad pipe in
first hole.
S+R done


NOV 10 1970

DRILLERS REMARKS:

MISS. BD. OF
WATER COMMISSIONERS

If well telescopes please sketch and show depths.

GROUND LEVEL

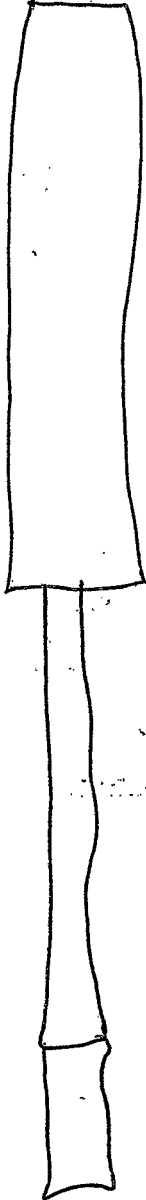


~~100 ft H¹
PVE~~

~~100 ft 2¹
PVE~~

~~10 ft 2¹ PVE
Screen~~

If more than one screen,
show locations of each on sketch.

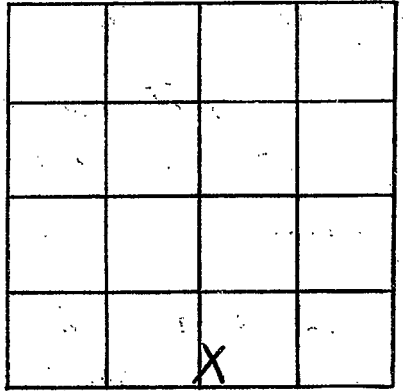

SECTION 22

Please indicate well location X.

ADDITIONAL INFORMATION

Blank lined area for additional information.