

Perry  
 H 16  
 7-5-73

MISSISSIPPI  
 BOARD OF WATER COMMISSIONERS  
 416 North State Street  
 Jackson, Mississippi 39201



WATER WELL DRILLERS LOG

July 5 1973 Cochran Drillers Perry  
 date well completed firm name county well located

LANDOWNER:  
 Cecil W. Hinton  
 Rt. 1, New Augusta  
 (mailing address)

description of formations encountered	from	to
Top soil	0	3
red clay	3	7
red sand	7	15
gray clay	15	28
light clay	28	39
sand	39	50

WELL LOCATION:  
 sec. 10 T. 3 N. R. 10 E. S. W3  
 12 miles N.E. of New Augusta  
 (distance) (direction) (nearest town)

WELL PURPOSE: home  
 (home, irrigation, municipal, industrial)

WELL COMPLETION DATA:

(1) diameter (inches) 2"

(2) total depth (feet) 50'

(3) static water level (feet) 17 below above top of ground.

(4) casing PVC 45'  
 (material) (depth)

         If telescope see back.  
 (size)

(5) screen 5' 45'  
 (length) (depth to top)

2" PVC  
 (size) (material)

(6) pump 1 6  
 (HP) (yield gpm)

Elect  
 (type power)

(7) electric log NO  
 (yes or no)

          
 (organization running log)

(8) how well bottom plugged valve




DRILLERS REMARKS:

NOV 5 1973

If well telescopes please sketch and show depths.

GROUND LEVEL

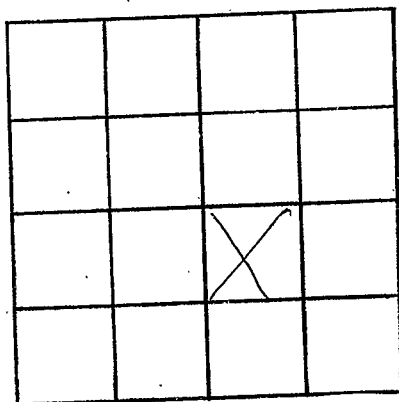

SECTION 10

Please indicate well location X.

ADDITIONAL INFORMATION

If more than one screen,  
show locations of each on sketch.