

lev. 115'

Perry
H 19
4-14-76

MISSISSIPPI CODED
BOARD OF WATER COMMISSIONERS C. P. CLARK
416 North State Street WATER WELL DRILLING
Jackson, Mississippi 39201 ROUTE 2
WATER WELL DRILLERS LOG LAUREL, MISS. 39440

4/14/76₁₉ date well completed C. P. Clark firm name Perry county well located

LANDOWNER: Leaf River Forest
Products Inc. New Augusta
Miss 39462 (Box 326)
(mailing address)


WELL LOCATION:
sec. 7 T. 3 (N) R. 10 E
2 miles N of Augusta
(distance) (direction) (nearest town)

WELL PURPOSE: drill
(home, irrigation, municipal, industrial)

- WELL COMPLETION DATA:
- (1) diameter (inches) 6
 - (2) total depth (feet) 223
 - (3) static water level (feet) 21 below above top of ground.
 - (4) casing 6 in Black Steel 192
(material) (depth)
4 if telescope see back.
(size)
 - (5) screen 30 193
(length) (depth to top)
4 in Solid S.S.
(size) (material)
 - (6) pump 1 1/2 33
(HP) (yield gpm)
2300 1φ
(type power)
 - (7) electric log No
(yes or no)
 - (organization running log)
 - (8) how well bottom plugged BWU

Description of formations encountered	from	to
Clay	0	12
sand & gravel	12	32
gravel	32	35
Blue Clay	35	150
Iron Clay	150	188
sand	188	223
Clay	223	275
sand	275	281
Clay	281	352
sand	352	356
Clay	356	400
sand	400	404
Clay & few sandy streaks	404	450

CODED

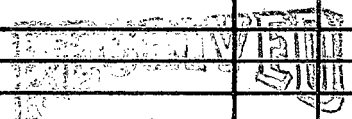


MAY 17 1976

DRILLERS REMARKS: Plan to install 1 1/2 HP 1500 RPM pump when 480V 3φ power available

MISSISSIPPI BOARD OF WATER COMMISSIONERS

If well telescopes please sketch and show depths.

GROUND LEVEL

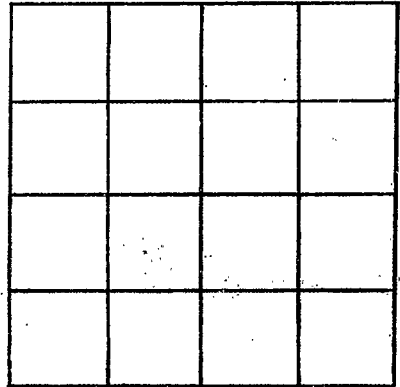

SECTION _____

Please indicate well location X.

ADDITIONAL INFORMATION

If more than one screen, show locations of each on sketch.