

PERRY
H 20
8-16-78

MISSISSIPPI
BOARD OF WATER COMMISSIONERS
416 North State Street
Jackson, Mississippi 39201

CODED

WATER WELL DRILLERS LOG

8-16-78 date well completed
1978 Gruner Drilling Perry firm name
county well located

LANDOWNER: Pel-Tex Oil Company
1100 Milam Building
Suite 3333
Houston, Texas 77002 (mailing address)

WELL LOCATION:
sec. 13 T. 3 N. R. 10 E. S. 5
Beaumont (nearest town)
(distance) (direction)

WELL PURPOSE:
(home, irrigation, municipal, industrial)

WELL COMPLETION DATA:

- (1) diameter (inches) 3"
- (2) total depth (feet) 351'
- (3) static water level (feet) 20' below top of ground.
- (4) casing steel 336' (material) (depth)
3" if telescope see back. (size)
- (5) screen 42' 294' (length) (depth to top)
3" perforated (size) (material)
- (6) pump (HP) 70 (yield gpm)
AC (type power)
- (7) electric log (yes or no)
- (organization running log)
- (8) how well bottom plugged orange
plug

Description of formations encountered	from	to
Clay - Permeable	21'	42'
Clay	42'	63'
struck	63'	84'
struck	84'	105'
struck	105'	126'
struck	126'	147'
Clay	147'	168'
Clay	168'	189'
struck	189'	213'
sand	213'	294'
sand & gravel	294'	315'
gravel	315'	336'
Clay	336'	351'

CODED


RECEIVED

AUG 22 1978

DRILLERS REMARKS:

If well telescopes please sketch and show depths.

GROUND LEVEL

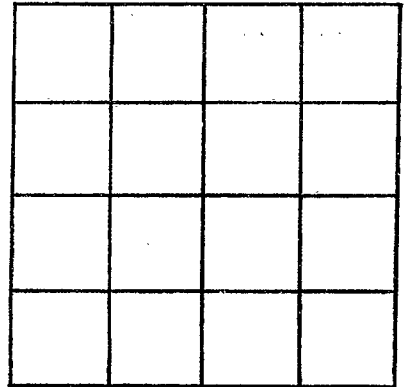

SECTION _____

Please indicate well location X.

ADDITIONAL INFORMATION

If more than one screen, show locations of each on sketch.