

Perry  
H 21  
9/26/78

MISSISSIPPI  
BOARD OF WATER COMMISSIONERS  
416 North State Street  
Jackson, Mississippi 39201

CODED

WATER WELL DRILLERS LOG


9/26 78 Griner Drilling Perry  
date well completed firm name county well located

LANDOWNER:	description of formations encountered	from	to
Pel-Tex Oil Company	Clay on top, P.G.	0	21
(mailing address)	clay + little sand	21	42
WELL LOCATION:	clay, small brecker of sand	42	105
sec. 13 T 30 N R 10 E S 10 W	clay	105	126
Beaumont (distance) (direction) (nearest town)	Clay on top, clay + sand on bottom	126	147
WELL PURPOSE:	Clay	148	168
(home, irrigation, municipal, industrial)	Clay + sand	168	300
WELL COMPLETION DATA:	Sand	301	324
(1) diameter (inches) 4"	1980' N + 1980' W		
(2) total depth (feet) 324'	of SE Cor.		
(3) static water level (feet) 50' below top of ground.			
(4) casing steel 324' (material) (depth)			
4" (size) If telescope see back.			
(5) screen 20' 30' (length) (depth to top)			
4" perforated (size) (material)			
(6) pump (HP) 70 (yield gpm)			
AC (type power)			
(7) electric log (yes or no)			
(organization running log)			
(8) how well bottom plugged orange			
peel			
DRILLERS REMARKS:			

RECEIVED  
OCT 30 1978  
MISS. BD. OF WATER COMMISSIONERS

If well telescopes please sketch and show depths.

GROUND LEVEL

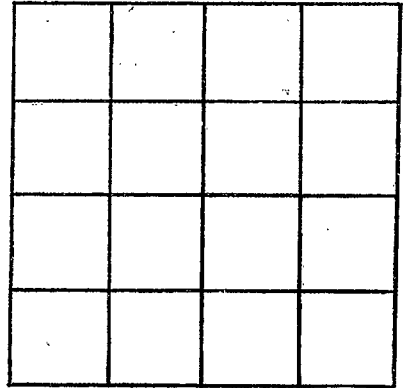

SECTION \_\_\_\_\_

Please indicate well location X.

ADDITIONAL INFORMATION

If more than one screen,  
show locations of each on sketch.