

Perry  
H 23  
3-10-81

MISSISSIPPI  
BOARD OF WATER COMMISSIONERS  
416 North State Street  
Jackson, Mississippi 39201

**CODED**

WATER WELL DRILLERS LOG

3-10-81 date well completed  
100 firm name  
Perry county well located

LANDOWNER: Jim Courtney  
Rt. 1 Box 341  
Beaumont, MS 39423  
(mailing address)

description of formations encountered	from	to
Top Soil	0	4
clay	4	25
sand	25	27
clay	27	70
Blue Clay	70	350
Fine Blue Sand	350	356
Blue Clay	356	400
med. white sand	400	434

WELL LOCATION:  
sec 29 T 3 N R 10 E  
3 miles N of Beaumont  
(distance) (direction) (nearest town)

WELL PURPOSE:  
(home, irrigation, municipal, industrial)

WELL COMPLETION DATA: 3-10-81


- (1) diameter (inches) 2"
- (2) total depth (feet) 434'
- (3) static water level (feet) 30'  below  above top of ground.
- (4) casing PVC, 404,  
(material) (depth)  
2"  
(size) if telescope see back.
- (5) screen 30', 404  
(length) (depth to top)  
2", PVC  
(size) (material)
- (6) pump 1, 15  
(HP) (yield gpm)  
E/E  
(type power)
- (7) electric log  (yes or no)

(organization running log)

(8) how well/bottom plugged 2" PVC  
Back wash

DRILLERS REMARKS:

**CODED**

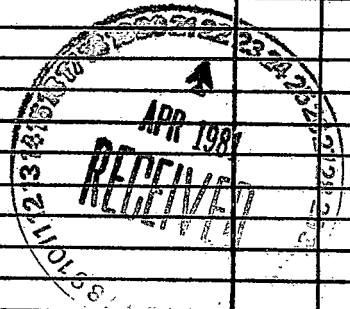


DEPT. OF NATURAL RESOURCES  
BUREAU OF LAND & WATER RESOURCES

APR 22 1981  
**RECEIVED**

If well telescopes please sketch and show depths.

GROUND LEVEL

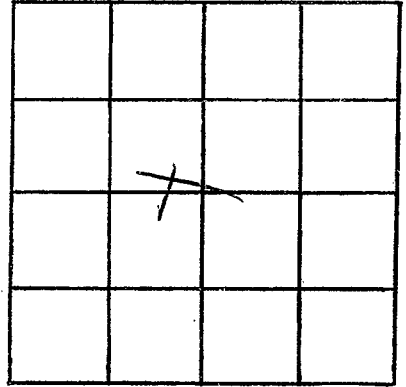

SECTION 27

Please indicate well location X.

ADDITIONAL INFORMATION

If more than one screen, show locations of each on sketch.