

Perry
H30
6-18-79

MISSISSIPPI
BOARD OF WATER COMMISSIONERS
416 North State Street
Jackson, Mississippi 39201

Berry

0226
CODED

WATER WELL DRILLERS LOG

6-18-79 date well completed
Floyd Howard well Ser. firm name
Perry county well located

LANDOWNER: Jim & Kay Davis
P.O. Box 412
Richton, ms. 39476
(mailing address)

WELL LOCATION:
sec. 25 T-3 N R-10 E
2 1/2 miles west of Beaumont
(distance) (direction) (nearest town)

WELL PURPOSE:
(home, irrigation, municipal, industrial)

- WELL COMPLETION DATA:
- (1) diameter (inches) 2
 - (2) total depth (feet) 538 ft
 - (3) static water level (feet) below
top of ground. above
 - (4) casing PVC, 538'
(material) (depth)
2" if telescope see back.
(size)
 - (5) screen 20', 518'
(length) (depth to top)
2", PVC
(size) (material)
 - (6) pump None, 8-10
(HP) (yield gpm)
None
(type power)
 - (7) electric log no
(yes or no)
no
(organization running log)
 - (8) how well bottom plugged PVC
2 valves

description of formations encountered	from	to
Clay	0	35
Sand (Fair)	35	40
Clay Sandy	40	105
Sand (poor)	105	121
Clay Sandy	121	140
Hard Clay	140	250
Sand	250	260
Clay (extra hard)	260	280
Sand	280	320
Sandy Clay	320	412
med white sand black	412	470
Sand blue course	470	510
SUN PEA gravel & EXTRA	510	538
course		

CODED

Miss. Board of Water Comm.

JUN 29 1979


RECEIVED

DRILLERS REMARKS: approx 4
to 6 ft pressure water
Quality good.

Paul R. Taylor

If well telescopes please sketch and show depths.

GROUND LEVEL

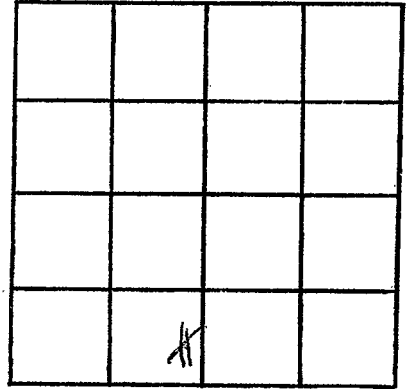

SECTION 25

Please indicate well location X.

ADDITIONAL INFORMATION

If more than one screen, show locations of each on sketch.