

Perry
H 31
12/79

MISSISSIPPI
BOARD OF WATER COMMISSIONERS
416 North State Street
Jackson, Mississippi 39201

CODED

WATER WELL DRILLERS LOG

Perry

date well completed 19 Free Flow Wells Inc. firm name Perry county well located

LANDOWNER: <u>Jim Langley</u>	description of formations encountered	from	to
<u>P.O. Box</u>	<u>Top Soil</u>	<u>0</u>	<u>30</u>
<u>New Augusta, MS.</u>	<u>Sand</u>	<u>30</u>	<u>35</u>
(mailing address)	<u>Clay</u>	<u>35</u>	<u>350</u>
	<u>Thin Smally Clay</u>	<u>350</u>	<u>500</u>
	<u>Med Sand</u>	<u>500</u>	<u>550</u>

WELL LOCATION:
26 SEC. 3 T. 3 N. R. 10 E.
3 1/2 miles W of Beumont
(distance) (direction) (nearest town)

CODED

WELL PURPOSE: Home
(home, irrigation, municipal, industrial)

WELL COMPLETION DATA:

- (1) diameter (inches) 2
- (2) total depth (feet) 540'
- (3) static water level (feet) 25' below top of ground. above
- (4) casing PVC 540'
(material) (depth)
no if telescope see back.
(size)
- (5) screen 20' 520'
(length) (depth to top)
2" PVC
(size) (material)
- (6) pump 1/2 HP 65
(HP) (yield gpm)
Elect
(type power)
- (7) electric log W
(yes or no)

(organization running log)

(8) how well bottom plugged PVC
Back Wash Valve

DRILLERS REMARKS: Free Flow
well approx 20 # Pressure
Flowed 400 gal Per Hour


DEPT. OF NATURAL RESOURCES
BUREAU OF LAND & WATER RESOURCES

DEC - 3 1979

RECEIVED

If well telescopes please sketch and show depths.

GROUND LEVEL

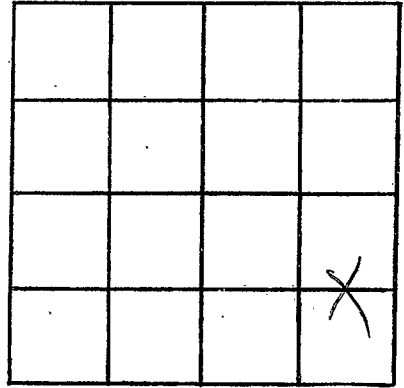

SECTION ~~20~~ 26

Please indicate well location X.

ADDITIONAL INFORMATION

If more than one screen,
show locations of each on sketch.