

MISSISSIPPI DEPARTMENT OF NATURAL RESOURCES

Bureau of Land and Water Resources

Southport Mall

P.O. Box 10631

Jackson, Mississippi 39209

WATER WELL DRILLERS LOG

H 32  
 PERRY CO  
 3-13-84

CODED

3-13-84 date well completed  
 Jayfosle water well firm name  
 Derry county well located

ELBERT LANDOWNER: Courtney  
 P.O. Box 87  
 New Augusta, MS 39462  
 (mailing address)

description of formations encountered	from	to
CLAY	0	76
SAND	76	90
CLAY	90	140
<del>SAND</del>	140	150
CLAY	150	156
SAND	156	160
CLAY	160	340
CLAY	340	370
SAND	370	450

WELL LOCATION:  
 sec. 27 T. 30 S. R. 10 E  
 3 miles EAST of New Augusta  
 (distance) (direction) (nearest town)

WELL PURPOSE:  
 (home, irrigation, municipal, industrial)

WELL COMPLETION DATA:

(1) diameter (inches) 2

(2) total depth (feet) 450

(3) static water level (feet) 40 below top of ground

(4) casing PVC (material), (depth)

(size) if telescope see back.

(5) screen 10' (length), (depth to top)

#6 (size), (material)

(6) pump 2 (HP), 10 (yield gpm)

(type power)

(7) electric log NO (yes or no)

(organization running log)

(8) how well bottom plugged PVC ball check

CODED

DEPT. OF NATURAL RESOURCES  
 BUREAU OF LAND & WATER RESOURCES


APR 29 1984

RECEIVED

DRILLERS REMARKS:

If well telescopes please sketch and show depths.

GROUND LEVEL

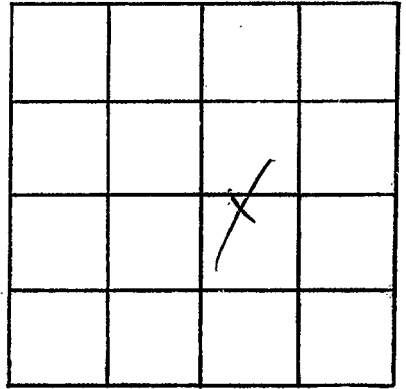

SECTION 1

Please indicate well location X.

ADDITIONAL INFORMATION

If more than one screen,  
show locations of each on sketch.