

Perry
H 35
6/28/84

MISSISSIPPI
BOARD OF WATER COMMISSIONERS
416 North State Street
Jackson, Mississippi 39201

CODED

WATER WELL DRILLERS LOG

JUNE 28 1984 Roy L. WEST Drilling Perry
date well completed firm name county well located

LANDOWNER:	description of formations encountered	from	to
LEAF RIVER FOREST PROD New Augusta MS (mailing address)			

WELL LOCATION:
sec. 7 T. 3 N R. 10 E
 5 W
1 miles N of New Augusta
(distance) (direction) (nearest town)

WELL PURPOSE: OFFICE
(home, irrigation, municipal, industrial)

WELL COMPLETION DATA:

(1) diameter (inches) 4"

(2) total depth (feet) 240'

(3) static water level (feet) 40' below above top of ground.

(4) casing PVC, 230'
(material) (depth)
(size) If telescope see back.

(5) screen 10', 230'
(length) (depth to top)
4" PVC
(size) (material)

(6) pump 1 26
(HP) (yield gpm)
REA
(type power)

(7) electric log no
(yes or no)

(organization running log)

(8) how well bottom plugged
WASH DRIVE

CODED

DEPT. OF NATURAL RESOURCES
BUREAU OF LAND & WATER RESOURCES


AUG 3 1984

RECEIVED

DRILLERS REMARKS:

If well telescopes please sketch and show depths.

GROUND LEVEL

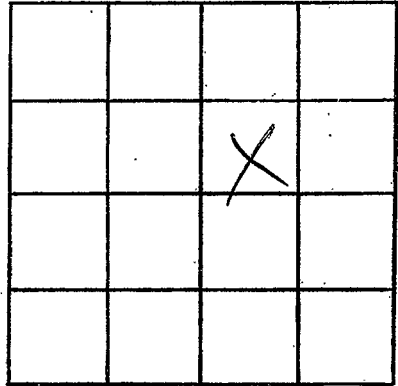

SECTION 7

Please indicate well location X.

ADDITIONAL INFORMATION

If more than one screen,
show locations of each on sketch.