

PERRY
H 37

MISSISSIPPI
BOARD OF WATER COMMISSIONERS
416 North State Street
Jackson, Mississippi 39201

CODED

WATER WELL DRILLERS LOG

Aug 5 1986 *P. H. Drilling Service, Inc.* Perry
date well completed firm name county well located

LANDOWNER: *Blain Sand and Gravel, Inc.*
PO Box 278, Mt. Olive, MS
(mailing address) *39119*


WELL LOCATION:
sec. *24* T *3* N R *H 10* E
3 miles *W* of *Beaumont*
(distance) (direction) (nearest town)

WELL PURPOSE:
(home, irrigation, municipal, industrial)

- WELL COMPLETION DATA:
- (1) diameter (inches) 2
 - (2) total depth (feet) 499
 - (3) static water level (feet) + below/above top of ground.
 - (4) casing PVC 485'
(material) (depth)
 - 2' if telescope see back.
(size)
 - (5) screen 10' 485'
(length) (depth to top)
 - 2" SS steel
(size) (material)
 - (6) pump 1 15
(HP) (yield gpm)
 - 220 V 1ph
(type power)
 - (7) electric log Yes
(yes or no)
 - P. H. Drilling Service
(organization running log)
 - (8) how well bottom plugged BWU
& steel ball

description of formations encountered	from	to
Top soil	0	1
Coarse sand	1	10
with clay	10	65
Sandy clay	65	72
Lat. gray clay	72	121
Dark clay & clay	121	209
Sandy clay at sh. Alth	209	216
clay	216	220
sand	220	223
Clay	223	248
Medium sand & clay	248	257
Clay, gray-green	257	267
Sand at sh. & clay	267	310
Clay	310	330
Sandy clay and clay	330	388
Sandy fine, powdery	388	401
Th. sh. sand, clay	401	480
& sandy clay	480	497 1/2
& sandy fine	497 1/2	499'
clay		

CODED

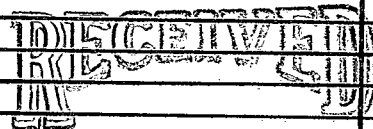


SEP 05 1986

Department of Natural Resources
Bureau of Land & Water Resources

DRILLERS REMARKS:

If well telescopes please sketch and show depths.

GROUND LEVEL

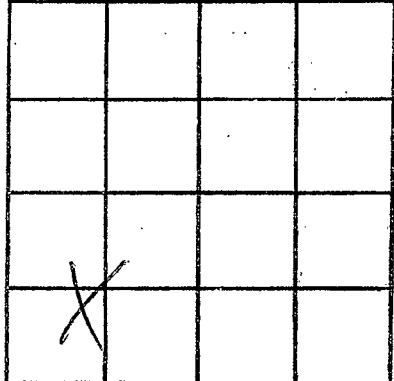

SECTION _____

Please indicate well location X.

ADDITIONAL INFORMATION

If more than one screen, show locations of each on sketch.