County: Perry Permit #: Driller: James M. Wells Date drilling completed: 10-29-13	D Mississippi Departu Office of La F Jackse (WELL REPORT Part 1 riller's Log nent of Environmental Quality nd and Water Resources O. Box 2309 on, MS 39225-2309 601)961-5210 1)360-0535 (fax)	For Office Use Only: Wett #: 1.0 k Aquifer:
State Law requires that this report Department at the above address w Well Owner Informat (Landowner if borehole is not for Owner Name: Vance Simp Mailing Address: 45 MOSS Mailing Address: 45 MOSS Petal MS City State Telephone No. (208) 303-4	ithin 30 days of con a water well) 2005 LC 39465 Zip Code	npletion of drilling of the well Well or Bor Latitude: <u>31°13.088</u> Lo CS Method of Lat/Long (check on USGS quad, Hand-held SE45VV4, Sec	rehole Location ongitude: 88'59.344
	water used for drilling a ne used in drilling a un Electric Gamm Well Geotechni nic Survey Other	ng: <u>FUNDING Cree</u> nd development: <u>GRANUL</u> na Ray Density Sonic Neutr	c
Purpose of Well (circle all applicable): Other (describe): If a flowing well, method of flow regul Static Water Level: <u>25</u> feet Method of measurement (circle one): Well depth: <u>80</u> Well grouted to a Casing length: <u>60</u> feet Screen length: <u>20</u> feet Screen slot size: <u>1008</u> inches Type of completion (circle all applicable)	Home Industrial ation: Valve t [above of below (circle one) Steel tape Electric depth of: _/O asing diameter: Screen diameter: Setting depth: e): Gravel packed	Public Supply Irrigation Other (describe) Other (describe) I land surface Date measure tape Air line Other (describe) teet Type of grout (circle one 4 inches Type of 9	Fish Culture ed: <u>10-29-13</u> e): e): Meat Cement Bentonite Mix f casing: <u>PVC</u> f screen: <u>PVC</u> to <u>SO</u> feet
Top of lap pipe or reduction in casing:	feet	one screen, describe on next p	age

Form:	OLWR-	SWR-1A	(4/13)


County:	Perry	
Permit #:	l	

For Office Use Only:

H6b Well #:

The sketch below only required for water wells

If well telescopes, show depths on sketch.

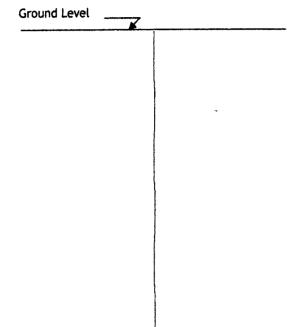

Description of formations encountered must be provided for all wells and boreholes, unless specifically exempted by regulations

Description of Formations Encountered	From (depth)	To (depth)
topsoil clay sand t peasawe	Ground level	1
clay	1	35
sand & peagowe	35	80
13	_	
-		

If more than one screen, show location of each on sketch

Sketch the property layout and include the following:

1) the well location

2) any permanent structures on the property that may aid in locating the well 3) any roads, power lines, or other items that may aid in locating the property

- How woll

4) north arrow	the terns that may all i			
	Rg		Cear Rive	
	9/05 V!		4	RECEIVED
Hwy 98	- B			
Landowner Name: Vance	Simmons			
I HEREBY CERTIFY that the well requirements of the Mississippi if applicable, and state laws.	l/borehole was drilled, Department of Environ	constructed, and commental Quality and	ompleted in accordance the Mississippi Departn	e with all applicable ment of Health regulations,
Dames M. Wells Print Name of Responsible Lice	00005889 Insee and License No.	11-14-13 Date	Jame r Signature	of Licensee

Signature of Licensee Form: OLWR-SWR-1A (4/13)

STATF W	ELL REPORT	
	Part 2	
County: Very Pump Installe	r's Completion Report	For Office Use Only:
Driller: James M. Wells Mississippi Departm	nent of Environmental Quality ad and Water Resources	Well #: 1462
Date completed: 10 arriv Jackso	.O. Box 2309 n, MS 39225-2309	Aquifer:
	01)961-5210) 360-0535 (fax)	
This part of the report must be completed by a licensed water of the report must be attached and both parts filed with the D	well contractor or a licensed pur epartment at the above address w	np installer. A copy of Part 1 Ithin 30 days of well completion
Well Owner Information		ocation
Owner Name: Vance Simmons	Latitude: <u>31°13,088</u> Lon	gitude: <u>88°59.344</u>
Mailing Address: 43 Moss Ln.	Method of Lat/Long (check one	-
$D_{2}L_{1}$ $M \leq 29415$	USGS quad, Hand-held G	
Vetal M13 39965 City State Zip Code		5 T 3N R 10W
Telephone No. (228) 323-4526	(Distance) Miles NE of	New Augusta (Nearestrown)
Pump Typ	oe (circle one)	
Submersible Turbine Air Lift Centrifugal Flowing Well		scribe):
Date Pump Installed: 10-29-13	lated Pump Capacity:	2Gallons Per Minut
Is This Pump (circle one): New Repaired Replacemer		·····
	pe (circle one)	
(lectric) Diesel Gasoline Natural Gas Tractor PTO Wind		
Horse Power Rating of Motor: Setting Dept	h: <u>50</u> feet Number	of Stages:
	for Non Flowing Well	//
Date Well Tested: 10-29-13 Duration of Pump Test (minimum 4 hours): 4 hour		
Static Water Level (A): Feet Below Land Surface		$\frac{20}{12}$ Feet Below Land Surface
Drawdown [(B) - (A)]:Feet Below Land Surf		
Method of measurement (circle one); Steel tape Electric ta	pe Air line Other (describe): _	
Pump Test Dat Measured shut in head:feet.	a for Flowing Well	
	fact offer	hours of ourself a
Well yieldedGPM with a drawdown of	nstallation	nours of pumping
Meter Manufacturer:	Meter Serial Number	and the second secon
Meter Model Number/Name:	Type of Meter:	the second s
Totalizer Register Unit and Multiplier Factor (AF x .001, gal		
Installation Date: Meter installed by: _		a a state
Is This Meter (circle one): New Repaired Replaceme	nt	
Important: By submitting the above information you are ce For agricultural wells, a list of app	rtifying that this meter was instal roved meters is on the MDEQ we	led to manufacturer standards. ebsite.
I HEREBY CERTIFY that the above statements are true to the		
Tames M. Wells 00005789 Print Name of Pump Installer and License No. (If applicable)	11-14-12 Same	m. curly
internative of rump installer and electrise no. (i) applicable)	Date Signat	ure of Pump Installer

Form: OLWR-SWR-1B (4/13)