

Perry
 H 2000
 4-29-76

MISSISSIPPI
 BOARD OF WATER COMMISSIONERS
 416 North State Street
 Jackson, Mississippi 39201

13p

WATER WELL DRILLERS LOG

April 29 1976 Cachran Drilling Inc Perry
 date well completed firm name county well located

LANDOWNER:

Harman Lott
 Rt 3 New Augusta
 (mailing address)

description of formations encountered

from to

top soil	0	2
red sand	2	14
white sand	14	33
brown clay	33	55
gray clay	55	68
blue clay	68	126
sand	126	149
blue clay	149	179
shale	179	198
blue clay	198	283
sand	283	296
sand shale	296	348
blue clay	348	457
white sand	457	510

WELL LOCATION:

sec. 14 T. 3 N. R. 10 E
 S. NW
 5 miles NE of New Augusta
 (distance) (direction) (nearest town)


WELL PURPOSE:

home (home, irrigation, municipal, industrial)

WELL COMPLETION DATA:

- (1) diameter (inches) 2"
- (2) total depth (feet) 510'
- (3) static water level (feet) below top of ground.
- (4) casing PVC, 500' (material) (depth)
2" (size) if telescope see back.
- (5) screen 10', 500' (length) (depth to top)
2" PVC (size) (material)
- (6) pump 58 (HP) (yield gpm)
 (type power)
- (7) electric log no (yes or no)
 (organization running log)
- (8) how well bottom plugged value


DRILLERS REMARKS:

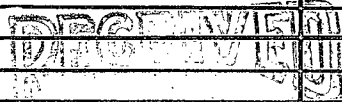

MAY 10 1976

If well telescopes please sketch and show depths.

GROUND LEVEL

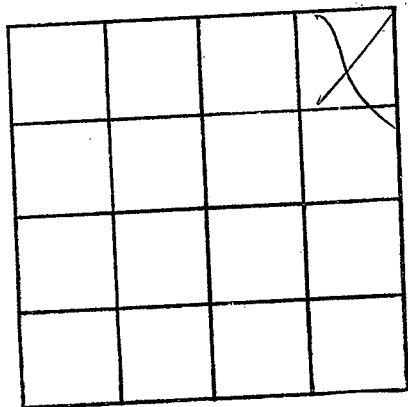

SECTION 127

Please indicate well location X.

ADDITIONAL INFORMATION

If more than one screen,
show locations of each on sketch.