

Perry
 H 2001
 5/23/77

MISSISSIPPI
 BOARD OF WATER COMMISSIONERS
 416 North State Street
 Jackson, Mississippi 39201
 C. P. CLARK
 WATER WELL DRILLING
 ROUTE 2
 LAUREL, MISS. 39440

5/23 1977 date well completed
 C. P. Clark firm name
 Perry county well located

LANDOWNER: W.W. Watson
 Pt # 1
 New Augusta Miss
 (mailing address)

description of formations encountered	from	to
Red sandy clay	0	10
Sand	10	20
Sand + gravel	20	33
Clay	33	52
Sand	52	85
Clay	85	92
Sand	92	110
Clay	110	220
Sand	220	247
Clay	247	250

WELL LOCATION:
 sec. 8 T. 30 N. R. 10 E.
 S. W.
 2 1/4 miles N of Augusta
 (distance) (direction) (nearest town)

WELL PURPOSE: Home
 (home, irrigation, municipal, industrial)

- WELL COMPLETION DATA:
- (1) diameter (inches) 2
 - (2) total depth (feet) 247
 - (3) static water level (feet) 40 below top of ground.
 - (4) casing Galv. Iron 237 (material) (depth)
 (size) If telescope see back.
 - (5) screen 10 237 (length) (depth to top)
 1 1/4 Solid S.S. 006 (size) (material)
 - (6) pump 1 1/2 15 (HP) (yield gpm)
 2300 (type power)
 - (7) electric log NO (yes or no)
 - (organization running log)
 - (8) how well bottom plugged BWU


RECEIVED
 JUN 15 1977

MISS. RD. OF WATER COMMISSIONERS

DRILLERS REMARKS:

If well telescopes please sketch and show depths.

GROUND LEVEL

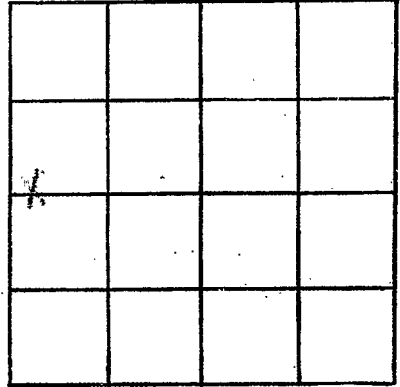

SECTION 8

Please indicate well location X.

ADDITIONAL INFORMATION

If more than one screen, show locations of each on sketch.