

Perry
H 2002
7/29/77

C. P. CLARK
MISSISSIPPI WATER WELL DRILLING
BOARD OF WATER COMMISSIONERS
 ROUTE 2
 416 North State Street, LAUREL, MISS. 39440
 Jackson, Mississippi 39201

WATER WELL DRILLERS LOG

7/29/77 1977 C.P. Clark Perry
 date well completed firm name county well located


LANDOWNER: <u>Ray Mathews</u> <u>New Augusta, Miss</u>	description of formations encountered	from	to
(mailing address)			
WELL LOCATION: <u>3</u> sec. <u>28</u> T. <u>20</u> N. R. <u>10</u> E. <u>2</u> miles <u>East</u> of <u>New Augusta</u> (distance) (direction) (nearest town)	<u>Clay</u>	<u>0</u>	<u>6</u>
	<u>Sand</u>	<u>6</u>	<u>14</u>
	<u>Clay</u>	<u>14</u>	<u>26</u>
	<u>Sandy Clay</u>	<u>26</u>	<u>33</u>
	<u>Clay</u>	<u>33</u>	<u>130</u>
	<u>Sand (fine)</u>	<u>130</u>	<u>148</u>
WELL PURPOSE: (home, irrigation, municipal, industrial)			
WELL COMPLETION DATA:			
(1) diameter (inches) <u>2</u>			
(2) total depth (feet) <u>147</u>			
(3) static water level (feet) <u>37</u> below above top of ground.			
(4) casing <u>Galv I</u> , <u>137</u> , (material) (depth)			
(size) if telescope see back.			
(5) screen <u>10</u> , <u>137</u> (length) (depth to top)			
<u>1 1/4</u> , <u>Solid 3.5 006</u> (size) (material)			
(6) pump <u>1 H.P.</u> , <u>15</u> (HP) (yield gpm)			
<u>2200</u> (type power)			
(7) electric log (yes or no)			
(organization running log)			
(8) how well bottom plugged <u>BWV</u>			
DRILLERS REMARKS: <u>Set 12A</u> <u>jet @ 63' Sta Rite</u> <u>pump 1 H.P. - 2 stage</u>			

RECEIVED
 OCT 10 1977

MISS. DIV. OF WATER CONTROL

If well telescopes please
sketch and show depths.

GROUND LEVEL

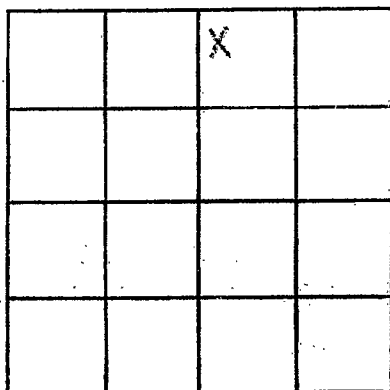

SECTION 22

Please indicate well location X.

ADDITIONAL INFORMATION

If more than one screen,
show locations of each on sketch.

Handwritten signature