

Perry
H 2003
5/26/77

MISSISSIPPI
BOARD OF WATER COMMISSIONERS
416 North State Street
Jackson, Mississippi 39201
P. CLARK
WATER WELL DRILLING
ROUTE 2
LAUREL, MISS. 39440

5/26 1977 P.P. Clark Perry
date well completed firm name county well located

LANDOWNER: J.D. Chapman
Rt # 1
New Augusta, Miss.
(mailing address)

WELL LOCATION:
sec. 7 T. 30 N. R. 10 E.
S W
2 1/2 miles N of New Augusta
(distance) (direction) (nearest town)

WELL PURPOSE: Camp house
(home, irrigation, municipal, industrial)

- WELL COMPLETION DATA:
- (1) diameter (inches) 2
 - (2) total depth (feet) 228
 - (3) static water level (feet) 27 below top of ground.
 - (4) casing Galv. iron 218 (material) (depth)
 - (5) screen 10 218 (length) (depth to top)
1 1/4 Solid SS #006 (size) (material)
 - (6) pump 1 13 1/2 (HP) (yield gpm)
2300 1 φ (type power)
 - (7) electric log No (yes or no)
 - (8) how well bottom plugged BWO

description of formations encountered	from	to
Red Sandy Clay	0	7
Sand	7	22
Sand & gravel	22	27
Blue Clay	27	161
Sand	161	163
Clay	163	205
Sand (med)	205	218
Coarse Sand	218	228
Clay	228	230


DRILLERS REMARKS: Set 12A
Get @ 42 ft
F + W pump 28 gpm

RECEIVED
JUN 15 1977

MISSISSIPPI WATER COMMISSION

If well telescopes please sketch and show depths.

GROUND LEVEL

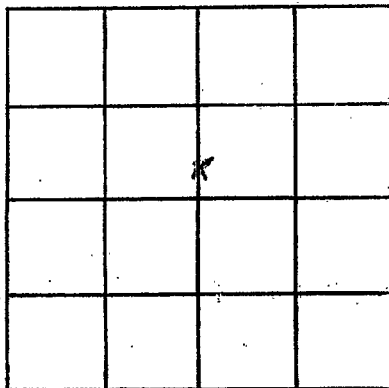

SECTION 7

Please indicate well location X.

ADDITIONAL INFORMATION

If more than one screen, show locations of each on sketch.