

PERRY
 H 2005
 8-21-78

MISSISSIPPI
 BOARD OF WATER COMMISSIONERS
 416 North State Street
 Jackson, Mississippi 39201

WATER WELL DRILLERS LOG

TOM GRIFFITH

PLUMBING & WELL SERVICE, INC. county well located

320 MAYSON AVE

COLUMBIA, MS 39429

Perry

8/21

19 7/8

date well completed

LANDOWNER:

Ester McSwain

P.O. Box 485 Beaumont
 (mailing address)

WELL LOCATION:

sec. 20 T 3 N R 10 E
 S W
4 miles E perfection
 (distance) (direction) (nearest town)

WELL PURPOSE: Home
 (home, irrigation, municipal, industrial)

WELL COMPLETION DATA:

- (1) diameter (inches) 2"
- (2) total depth (feet) 25 ft.
- (3) static water level (feet) ? below above top of ground.
- (4) casing plastic
 (material) (depth)
 (size) if telescope see back.
- (5) screen (length) (depth to top)
 (size) plastic
 (material)
- (6) pump no pump
 (HP) (yield gpm)
 (type power)
- (7) electric log (yes or no)
- (8) how well bottom plugged

DRILLERS REMARKS:

description of formations encountered

from to


<i>Topsoil</i>	<i>0</i>	<i>2</i>
<i>Sand</i>	<i>2</i>	<i>12</i>
<i>Chalk</i>	<i>12</i>	<i>18</i>
<i>Sand</i>	<i>18</i>	<i>25</i>

RECEIVED
 OCT 10 1978

MISS. BD. OF WATER COMMISSIONERS

If well telescopes please sketch and show depths.

GROUND LEVEL

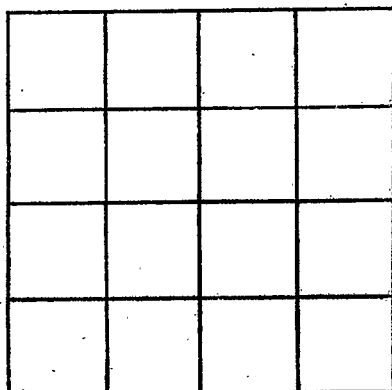

SECTION _____

Please indicate well location X.

ADDITIONAL INFORMATION

If more than one screen, show locations of each on sketch.