

Perry
H 2000
5/12/79

MISSISSIPPI
BOARD OF WATER COMMISSIONERS
416 North State Street
Jackson, Mississippi 39201

WATER WELL DRILLERS LOG

5/12/79 19 Friggie Well Serv Perry
date well completed firm name county well located

LANDOWNER: Thomas Mc Quin
Box 45
New Augusta, MS 39462
(mailing address)

description of formations encountered	from	to
Top Soil	0	48
Fine Sand	48	100
Blue Clay	100	230
Fine Sand	230	300
Loose Clay	300	350
Blue Clay	350	520
Med. Sand	520	590

WELL LOCATION:
sec 21 T 30 N R 10 E
S W
4 miles W of Blount
(distance) (direction) (nearest town)

WELL PURPOSE: Animal
(home, irrigation, municipal, industrial)

- WELL COMPLETION DATA:
- (1) diameter (inches) 2
 - (2) total depth (feet) 590
 - (3) static water level (feet) 60 below top of ground.
 - (4) casing PVC, 560 (material) (depth)
 - (size) if telescope see back.
 - (5) screen 30' 560 (length) (depth to top)
 - 2" PVC (size) (material)
 - (6) pump 1 10 (HP) (yield gpm)
 - Elect (type power)
 - (7) electric log NO (yes or no)
 - NO (organization running log)
 - (8) how well bottom plugged PVC Beer Wash

DRILLERS REMARKS:


DEPT. OF NATURAL RESOURCES
BUREAU OF LAND & WATER RESOURCES

DEC - 3 1979

RECEIVED

If well telescopes please sketch and show depths.

GROUND LEVEL

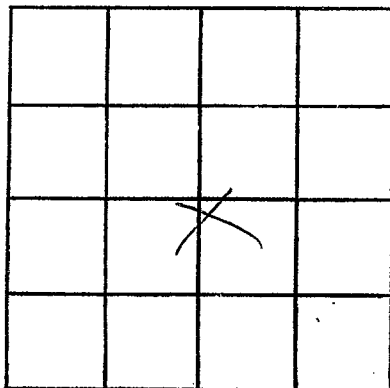

SECTION 27

Please indicate well location X.

ADDITIONAL INFORMATION

If more than one screen,
show locations of each on sketch.