

MISSISSIPPI DEPARTMENT OF NATURAL RESOURCES

Bureau of Land and Water Resources

Southport Mall

P.O. Box 10631

Jackson, Mississippi 39209

WATER WELL DRILLERS LOG

Perry
H 2007

6-11-82
date well completed

Fryberg & Watson
firm name

Perry
county well located

LANDOWNER: Rebecca Pierce
P.O. Box 181
New Augusta, MS 39462
(mailing address)

description of formations encountered

from to

WELL LOCATION:
sec. 25 3 N R. 10 E
2 miles E of New Augusta
(distance) (direction) (nearest town)

<u>TOP SOIL</u>	<u>0</u>	<u>10</u>
<u>Clay</u>	<u>10</u>	<u>18</u>
<u>SAND</u>	<u>18</u>	<u>30</u>
<u>clay</u>	<u>30</u>	<u>40</u>
<u>Clay</u>	<u>40</u>	<u>44</u>
<u>Fine Sand</u>	<u>44</u>	<u>60</u>
<u>Med Sand</u>	<u>60</u>	<u>80</u>
<u>Clay</u>	<u>80</u>	<u>90</u>
<u>SAND med</u>	<u>90</u>	<u>110</u>

WELL PURPOSE:
(home) irrigation, municipal, industrial

WELL COMPLETION DATA:

- (1) diameter (inches) 4"
- (2) total depth (feet) 110'
- (3) static water level (feet) 50' below above top of ground.
- (4) casing PVC 100'
(material) (depth)
no' if telescope see back.
(size)
- (5) screen 10' 100'
(length) (depth to top)
4' PVC
(size) (material)
- (6) pump 1/3 20
(HP) (yield gpm)
Electric
(type power)
- (7) electric log no (yes or no)
no
(organization running log)
- (8) how well bottom plugged PVC
Ball check

DEPT. OF NATURAL RESOURCES
BUREAU OF LAND & WATER RESOURCES


NOV - 8 1982

RECEIVED

DRILLERS REMARKS: Plenty water

If well telescopes please
sketch and show depths.

GROUND LEVEL

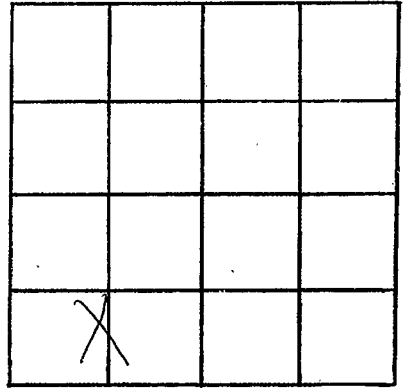

SECTION 25

Please indicate well location X.

ADDITIONAL INFORMATION

If more than one screen,
show locations of each on sketch.