

Perry
H
2008

MISSISSIPPI DEPARTMENT OF NATURAL RESOURCES
Bureau of Land and Water Resources
Southport Mall
P.O. Box 10631
Jackson, Mississippi 39209
WATER WELL DRILLERS LOG


June 16-1983 date well completed
Cochran Water Well Service firm name
Perry county well located

| LANDOWNER: | description of formations encountered | from | to |
|--|---------------------------------------|------|----|
| Author Creel Rt 1 New Augusta (mailing address) | | | |
| WELL LOCATION: sec. 5 T. 3 N. R. 10 E 8 miles NE of New Augusta (distance) (direction) (nearest town) | | | |
| WELL PURPOSE: (home irrigation, municipal, industrial) | | | |
| WELL COMPLETION DATA: (1) diameter (inches) 2" (2) total depth (feet) 42' (3) static water level (feet) 19 below top of ground. (4) casing PVC 36' (material) (depth) (size) if telescope see back. (5) screen 5' 36' (length) (depth to top) 2" PVC (size) (material) (6) pump 1 9 (HP) (yield gpm) Elec. (type power) (7) electric log NO (yes or no) (organization running log) (8) how well bottom plugged valve | | | |
| DRILLERS REMARKS: | | | |

DEPT. OF NATURAL RESOURCES
BUREAU OF LAND & WATER RESOURCES
SEP 18 1983
RECEIVED

If well telescopes please sketch and show depths.

GROUND LEVEL

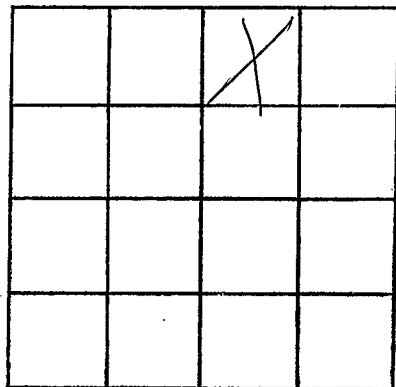

SECTION 5

Please indicate well location X.

ADDITIONAL INFORMATION

If more than one screen,
show locations of each on sketch.