

MISSISSIPPI DEPARTMENT OF NATURAL RESOURCES

Bureau of Land and Water Resources

Southport Mall

P.O. Box 10631

Jackson, Mississippi 39209

WATER WELL DRILLERS LOG

Perry
H
2009

21

9-25 1983 FRYFOGIE WATER Well PERRY
 date well completed firm name county well located

LANDOWNER: Billy R. BENN
P.O. BOX 351
New Augusta, MS.
 (mailing address)

WELL LOCATION:
 sec 25 T 3 N R 10 E
4 miles West of BRANNON
 (distance) (direction) (nearest town)

WELL PURPOSE:
 (home, irrigation, municipal, industrial)

WELL COMPLETION DATA:
 (1) diameter (inches) 2"
 (2) total depth (feet) 516
 (3) static water level (feet) 1 below top of ground
 (4) casing PVC 516
 (material) (depth)
2 if telescope see back.
 (size)
 (5) screen 20'
 (length) (depth to top)
#8 PVC
 (size) (material)
 (6) pump 1/2
 (HP) (yield gpm)
 (type power)
 (7) electric log NO
 (yes or no)
 (organization running log)
 (8) how well bottom plugged

description of formations encountered	from	to
TOP SOIL	0	5
FINE SAND	5	20
Clay BROWN	20	40
Clay yellow & brown	40	60
FINE SAND	60	80
CLAY	80	200
strips clay 4" to 12" strips sand	200	300
CLAY	300	400
strips sand 4" to 12"	400	450
Clay		
Soft sand & clay	450	460
Soft FINE SAND	460	470
Soft sand FINE	470	480
SOFT med sand	480	499
SOFT Med sand	500	516


DEPT. OF NATURAL RESOURCES
 BUREAU OF LAND & WATER RESOURCES

OCT 31 1983
 RECEIVED

DRILLERS REMARKS:

If well telescopes please sketch and show depths.

GROUND LEVEL

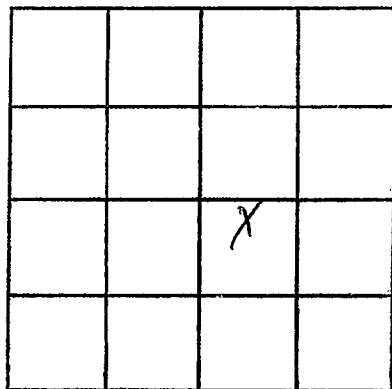

SECTION 4

Please indicate well location X.

ADDITIONAL INFORMATION

57

If more than one screen;
show locations of each on sketch.