

MISSISSIPPI DEPARTMENT OF NATURAL RESOURCES

Bureau of Land and Water Resources

Southport Mall

P.O. Box 10631

Jackson, Mississippi 39209

WATER WELL DRILLERS LOG

<i>Perry</i>
<i>H</i>
<i>2010</i>

May 14-1994 date well completed *Cochran Water Well Service* firm name *Perry* county well located

LANDOWNER:	description of formations encountered	from	to
<i>Jimmy Kid</i> <i>R.I. Dewhurst</i> (mailing address)			
	<i>brown clay</i>	<i>1</i>	<i>6</i>
	<i>sand</i>	<i>6</i>	<i>12</i>
	<i>Gray clay</i>	<i>12</i>	<i>21</i>
	<i>sand</i>	<i>21</i>	<i>38</i>
WELL LOCATION: sec. <i>4</i> T. <i>2</i> N. R. <i>10</i> S. <i>W</i> <i>7</i> miles <i>NE</i> of <i>New Augusta</i> (distance) (direction) (nearest town)			
WELL PURPOSE: <input checked="" type="checkbox"/> (home, irrigation, municipal, industrial)			
WELL COMPLETION DATA:			
(1) diameter (inches) <i>2"</i>			
(2) total depth (feet) <i>38'</i>			
(3) static water level (feet) <i>12</i> below above top of ground.			
(4) casing <i>PVC</i> , <i>33'</i> (material) (depth)			
<i>2"</i> (size) If telescope see back.			
(5) screen <i>5'</i> , <i>33'</i> (length) (depth to top)			
<i>2"</i> , <i>PVC</i> (size) (material)			
(6) pump <i>1</i> , <i>8'</i> (HP) (yield gpm)			
<i>elec</i> (type power)			
(7) electric log _____ (yes or no)			
_____ (organization running log)			
(8) how well bottom plugged <i>values</i>			
DRILLERS REMARKS:			


DEPT. OF NATURAL RESOURCES
BUREAU OF LAND & WATER RESOURCES

JUN - 4 1994

RECEIVED

If well telescopes please sketch and show depths.

GROUND LEVEL

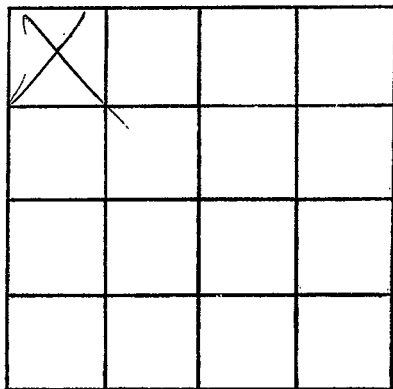

SECTION 4

Please indicate well location X.

ADDITIONAL INFORMATION

If more than one screen,
show locations of each on sketch.