

MISSISSIPPI DEPARTMENT OF NATURAL RESOURCES

Bureau of Land and Water Resources

Southport Mall

P.O. Box 10631

Jackson, Mississippi 39209

WATER WELL DRILLERS LOG

~~Forest~~  
 PERRY  
 14 2011

PERRY  
~~FOREST~~

12-2 1985 Fryfogle Well Serv. GREEN  
 date well completed firm name county well located

LANDOWNER: Phillip McSwain  
 Beaumont, MS  
 (mailing address)

description of formations encountered	from	to
TOP Soil	0	10
Clay	10	20
Sand	20	22
Clay	22	480
Sand	480	560

WELL LOCATION:  
 sec. 28 T. 3 N. R. 10 E.  
 5 miles NW of Beaumont  
 (distance) (direction) (nearest town)

WELL PURPOSE: Home  
 (home, irrigation, municipal, industrial)

- WELL COMPLETION DATA:
- (1) diameter (inches) 2"
  - (2) total depth (feet) 500'
  - (3) static water level (feet) 20' below above top of ground.
  - (4) casing PVC, 490' (material) (depth)
  - NO (size) if telescope see back.
  - (5) screen 10, 490' (length) (depth to top)
  - 2" PVC (size) (material)
  - (6) pump 1, 10 (HP) (yield gpm)
  - Elect (type power)
  - (7) electric log NO (yes or no)
  - NO (organization running log)
  - (8) how well bottom plugged PVC Ball check

RECEIVED


MAR 19 1986

Department of Natural Resources  
 Bureau of Land & Water Resources

DRILLERS REMARKS:

If well telescopes please  
sketch and show depths.

GROUND LEVEL

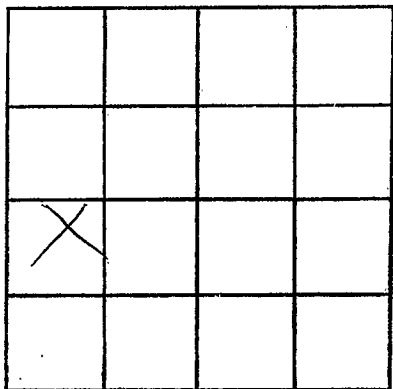

SECTION 28

Please indicate well location X.

ADDITIONAL INFORMATION

If more than one screen,  
show locations of each on sketch.