

MISSISSIPPI DEPARTMENT OF NATURAL RESOURCES

Bureau of Land and Water Resources

Southport Mall

P.O. Box 10631

Jackson, Mississippi 39209

WATER WELL DRILLERS LOG

Permy
H 2012


Dec. 15, 1985 date well completed      Cochran Water Well Service firm name      Perry county well located

LANDOWNER:	description of formations encountered	from	to
Douglas meek Rt 1 New Augusta (mailing address)			
	sand	0	25
	gray clay	25	31
	sand & gravel	31	80

WELL LOCATION:  
 sec. 16 T. 30 N. R. 10 E.  
 S W  
 5 miles N-E of New Augusta  
 (distance) (direction) (nearest town)

WELL PURPOSE:  
 home  irrigation, municipal, industrial

- WELL COMPLETION DATA:
- (1) diameter (inches) 2"
  - (2) total depth (feet) 80'
  - (3) static water level (feet) 23'  below  above top of ground.
  - (4) casing PVC 75'  
 (material) (depth)  
 (size) If telescope see back.
  - (5) screen 5' 75'  
 (length) (depth to top)  
2" (size) PVC (material)
  - (6) pump 1 7  
 (HP) (yield gpm)  
ELC (type power)
  - (7) electric log         
 (yes or no)  
 (organization running log)
  - (8) how well bottom plugged value

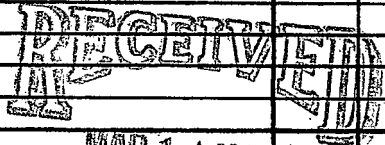


MAR 14 1986

Department of Natural Resources  
 Bureau of Land & Water Resources

DRILLERS REMARKS:

If well telescopes please  
sketch and show depths.

GROUND LEVEL

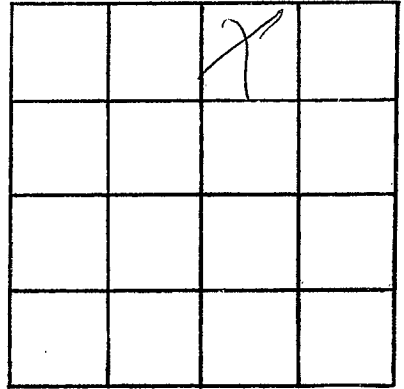

SECTION 16

Please indicate well location X.

ADDITIONAL INFORMATION

If more than one screen,  
show locations of each on sketch.