

MISSISSIPPI DEPARTMENT OF NATURAL RESOURCES

Bureau of Land and Water Resources

Southport Mall

P.O. Box 10631

Jackson, Mississippi 39209

WATER WELL DRILLERS LOG

PERRY
H 2014

June 9 1985 Coehran Water Well Service Perry
date well completed firm name county well located


LANDOWNER:	description of formations encountered	from	to
Ruthie Myrett Rt 1 New Augusta (mailing address)			
WELL LOCATION:	TOP Soil	0	1
sec. 16 T 30 N R 10 E	Sand Soil	1	5
5 miles N-E of New Augusta	Gray & Blue	5	18
(distance) (direction) (nearest town)	Sand & gravel	18	20
WELL PURPOSE:			
(home, irrigation, municipal, industrial)			
WELL COMPLETION DATA:			
(1) diameter (inches) 2"			
(2) total depth (feet) 100'			
(3) static water level (feet) 28' below top of ground.			
(4) casing PVC 90' (material), 2" (size) if telescope see back.			
(5) screen 10' 90' (length), 2" (size), PVC (material)			
(6) pump 1 (HP), 8 (yield gpm), Elec. (type power)			
(7) electric log (yes or no)			
(organization running log)			
(8) how well bottom plugged Valve			
DRILLERS REMARKS:			

RECEIVED
AUG 20 1985

Department of Natural Resources
Bureau of Land & Water Resources

If well telescopes please sketch and show depths.

GROUND LEVEL

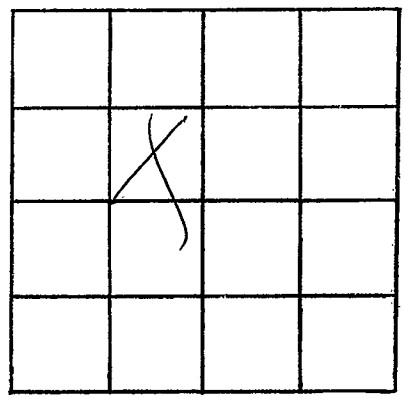

SECTION 16

Please indicate well location X.

ADDITIONAL INFORMATION

If more than one screen, show locations of each on sketch.