

MISSISSIPPI DEPARTMENT OF NATURAL RESOURCES
Bureau of Land and Water Resources

P.O. Box 10631
Jackson, Mississippi 39209
WATER WELL DRILLERS LOG

COUNTY WELL LOCATED Perry	
WELL NUMBER H2016	CODED
DATE WELL COMPLETED 10-9-90	

PERMIT NUMBER
NAME OF DRILLING FIRM Boone's Waterwell

NAME & MAILING ADDRESS OF LANDOWNER Hood Industries Beaumont MS		
WELL LOCATION: SEC 26 TOWNSHIP 3 RANGE N 100 E		
DISTANCE 1 Miles	DIRECTION W	NEAREST TOWN Beaumont
OTHER LANDMARK		
WELL PURPOSE: Home, Irrigation, Municipal, <u>Industrial</u> , Fish Pond, etc.		

PUMP DATA		
PUMP TYPE (Circle One): Submersible, Turbine, Jet <u>Flowing Well</u> Other (Describe)		
POWER TYPE (Circle One): Electric, Tractor, Diesel, Gasoline, Butane, Other (Describe) <u>H/P</u>		
Pump Capacity (GPM)	No. of Stages	Setting Depth FT.
PUMP TEST		
Well yielded <u>20</u> GPM with a drawdown of _____ ft. after _____ hours of pumping		

WELL DATA		
Well Depth 548	Casing Diameter (In.) 2	Casing Length (Ft.) 518
Type of Casing sch 40	Hole Depth 518	Depth to Static Water Level Flowing
TYPE OF COMPLETION: (Circle One or More): <u>Gravel Packed</u> , Underreamed, Telescoped, Natural Development, Open Hole, Other		
Top of Lap Pipe or Reduction in Casing FEET <input type="checkbox"/> IF TELESCOPED OR MORE THAN ONE SCREEN: USE BACK PAGE		

LOG DATA	
TYPE OF LOG RUN (Circle One): Electric, Gamma Ray, Density, Sonic, Neutron, Other (Describe) <u>No Log Run</u>	
Name of Organization Running Log	

SCREEN DATA		
Diameter - Inches 2	Length - Feet 30	Slot Size - Inches # 10
Screen Type sch 80		Depth to Bottom - Feet


GEOLOGIC DATA (Office Use Only)			
Surface Elev.	Geologic Unit	Unit Thickness	Depth to Top
Subs. SWL	Date	Analysis	Aquifer Test
Driller's Remarks Drill and set casing + wash out only			

DESCRIPTION OF FORMATIONS ENCOUNTERED	FROM	TO
Coarse Sand	0	15
Pea Gravel	15	22
White Clay	22	60
Blue Clay	60	208
Sand	208	212
Blue Clay	212	340
Sand	340	346
Blue Clay	346	428
medium sand	428	548

FORMATIONS (Continued)	FROM	TO
RECEIVED		
OCT 24 1990		
Department of Natural Resources Bureau of Land & Water Resources		
IF MORE SPACE IS NEEDED, USE BACK		

If well telescopes please
sketch and show depths.

GROUND LEVEL

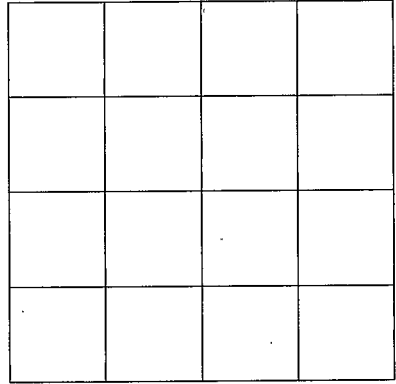

SECTION _____

Please indicate well location X.

ADDITIONAL INFORMATION

If more than one screen,
show location of each on sketch.