

PERRY


2

J
9-25-61

WATER WELL DRILLERS LOG

Date: 9-25, 1961, Driller: HERMON PARKER County PERRY
(Name)

(1) Owner of Land:	Description & Color of Materials Sand, Clay, Red Clay, Shell, etc.	Thick- ness Feet	Depth Feet
<u>George Weiss</u> (Name) <u>Beaumont, Miss</u> (Address)	<u>Red CLAY</u> <u>SAND</u>	<u>25</u> <u>86</u>	<u>25</u> <u>111</u>
(2) Location: <u>1/4</u> , <u>1/4</u> , Sec. <u>4</u> T. <u>R.</u> <u>8</u> miles <u>South</u> of <u>Richton</u> (distance) (direction) (Nearest Town)			
(3) Topography: <u>Hilly</u> (Hilly) (Flat) (Level)			
(4) Purpose of Well: <u>Domestic</u> (Domestic Irrigation Municipal, Industrial, Other)			
Information upon completion of well:			
(1) Diameter <u>2</u> inches.			
(2) Total Depth: <u>111</u> feet.			
(3) Water Level: 47 <u>33</u> feet below top of ground.			
(4) Cased to <u>111</u> , Size <u>2"</u>			
(5) Screen: Size <u>2"</u> , Length <u>5'</u>			
(6) Were any formations sealed against pollution?			
<input type="checkbox"/> yes, <input checked="" type="checkbox"/> <u>no</u> .			
If YES depth of formation _____			
Why _____			
Drillers Remarks: _____			

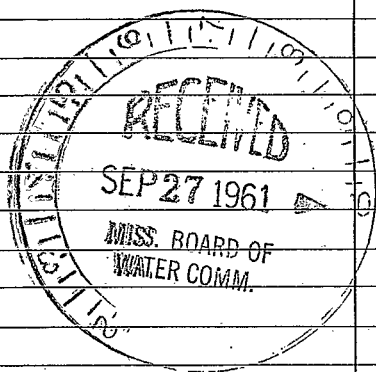

34

Well No.

(Use Back Side)

