

MISSISSIPPI BOARD OF WATER COMMISSIONERS

Perry
J 13
6-5-66

WATER WELL DRILLERS LOG

Date: June 5, 1966, Driller: James, County: Perry
(Name)

(1) Owner of Land:	Description & Color of Materials Sand, Clay, Red Clay, Shell, etc.	Thick- ness Feet	Depth Feet
<u>Robert Joyce</u> (Name) <u>Beaumont, Miss.</u> (Address)	<u>red sands</u> <u>blue clay</u> <u>sand</u>	<u>0</u> <u>90</u> <u>174</u>	<u>20</u> <u>174</u> <u>179</u>
(2) Location: $\frac{1}{4}$, $\frac{1}{4}$, Sec <u>26</u> T <u>3</u> R <u>9</u> , <u>6</u> miles <u>N.E.</u> , of <u>Beaumont</u> , (distance) (direction) (Nearest Town)			
(3) Topography: <input checked="" type="checkbox"/> (Hilly) <input type="checkbox"/> (Flat) <input type="checkbox"/> (Level)			
(4) Purpose of Well: <u>Domestic</u> (Domestic Irrigation Municipal, Industrial, Other)			


Information upon completion of well:

- (1) Diameter 2 inches.
- (2) Total Depth 179 feet.
- (3) Water Level 70 feet below top of ground.
- (4) Cased to 174, Size 2 in.
- (5) Screen: Size 2", Length 5 ft.
- (6) Were any formations sealed against pollution?
 yes, no.

If YES depth of formation _____

Why _____

Drillers Remarks: _____

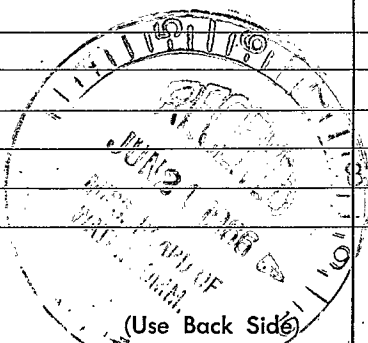

Well No.

