

PERRY

J14

8-3-60

WATER WELL DRILLERS LOG

CODED

Date: 8-3, 1960, Driller: Zuck & Grace, County: P.R.

540/600 576/1.1

(Name)

From to:

(1) Owner of Land: Henry J. J. Beaumont, Mass. (Name) (Address)

(2) Location: 1/4, 1/4, Sec. 32 T 3 R 9, 2.9 miles east of Hamburg (distance) (direction) (Nearest Town)

(3) Topography: (Hilly) (Flat) (Level)

(4) Purpose of Well: Domestic (Domestic Irrigation, Municipal, Industrial, Other)

Description & Color of Materials Sand, Clay, Red Clay, Shell, etc.	Thickness Feet	Depth Feet
Surface Clay	0	40
Sand + gravel	40	65
Blue Clay	65	400
Fine Sand	400	450
Blue Clay	450	515
good sand	515	599

Information upon completion of well:

- (1) Diameter: 2 inches.
- (2) Total Depth: 599 feet.
- (3) Water Level: Flow feet below top of ground.
- (4) Cased to: _____, Size: _____
- (5) Screen: Size 2", Length 10'
- (6) Were any formations sealed against pollution? _____ yes, no no.


If YES depth of formation _____

Why _____

Drillers Remarks: _____

Good Flow

CODED

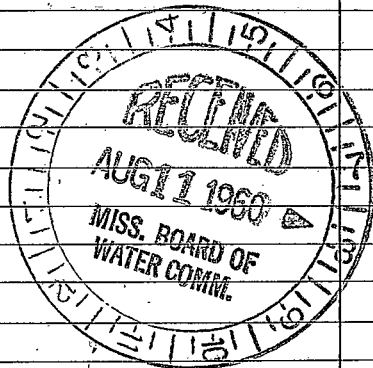

(Use Back Side)

Well No.

