

PERRY
J/16

MISSISSIPPI BOARD OF WATER COMMISSIONERS

75

10-24-61

WATER WELL DRILLERS LOG

Date: 10-24, 1961, Driller: HERMAN PARKER County PERRY

(Name)

	Description & Color of Materials Sand, Clay, Red Clay, Shell, etc.	Thick- ness Feet	Depth Feet
(1) Owner of Land: <u>L. B. GARDNER</u> (Name)	<u>RED CLAY</u>	<u>27</u>	<u>27</u>
<u>Richton, Miss.</u> (Address)	<u>GRAVEL</u>	<u>24</u>	<u>51</u>
(2) Location: <u>1/4</u> , <u>1/4</u> , Sec. <u>7</u> T. <u>R.</u>	<u>SAND</u>	<u>14</u>	<u>65</u>
<u>9</u> miles <u>S-EAST</u> of <u>Richton</u> (distance) (direction) (Nearest Town)			
(3) Topography: <u>FLAT</u> (Hilly) (Flat) (Level)			
(4) Purpose of Well: <u>DOMESTIC</u> (Domestic Irrigation Municipal, Industrial, Other)			


Information upon completion of well:

- (1) Diameter 2 inches.
- (2) Total Depth 65 feet.
- (3) Water Level 37 feet below top of ground.
- (4) Cased to 65', Size 2"
- (5) Screen: Size 2", Length 5'
- (6) Were any formations sealed against pollution?
_____ yes, NO no.

If YES depth of formation _____

Why _____

Drillers Remarks: _____

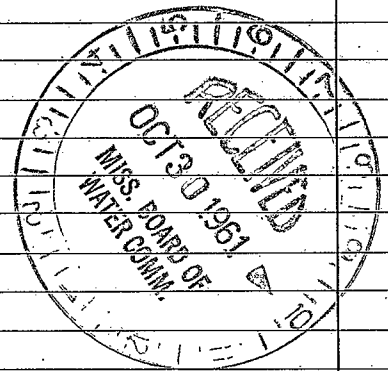

38

Well No.

(Use Back Side)

[The page contains extremely faint and illegible text, likely bleed-through from the reverse side of the document. No specific words or phrases can be discerned.]